

SURVEY & REMONUMENTATION

APR 25 1995

OTTAWA COUNTY REMONUMENTATION
LAND CORNER RECORDATION CERTIFICATE
 Filing Requirement of Act 74, Mich. P.A. 1970

RECORDED

94 DEC -8 PM 12:30


For corners in **COMMISSION**

<u>Ottawa</u> <small>(County)</small>	Located In: Jamestown Township	Corner Code # E-10
1. Public Land Survey	T <u>5N</u> R <u>13W</u>	<u>E-10</u>
	T _____ R _____	_____
	T _____ R _____	_____
	T _____ R _____	_____
2. Property Controlling in Section	S _____ T _____ R _____	_____
	S _____ T _____ R _____	_____
3. Miscellaneous Property in Sec.	S _____ T _____ R _____	_____
	S _____ T _____ R _____	_____
4. Lot No. _____, Recorded Plat _____		
5. Private Claims _____		

Polystia Redman
 REGISTER OF DEEDS
 OTTAWA COUNTY, MI

Register of Deeds Stamp & File Number

Rodney D. Unema in a field survey on Nov. 16, 1994
 do hereby certify that under requirements of P.A. 74, Michigan P.A. of 1970, the corner points mentioned in lines 1 and 2 above were in conformance with regulations and rules therefore as required in the current manual of survey instructions of the United States Department of the Interior, Bureau of Land Management or by a decree of a Court of Law and/or that the corner points mentioned in lines 3, 4 and 5 above were in conformance with the rules of the Michigan Board of Land Surveyors or by a Decree of a Court of Law; established, re-established, monumented, re-monumented, recovered, found as expressed below:

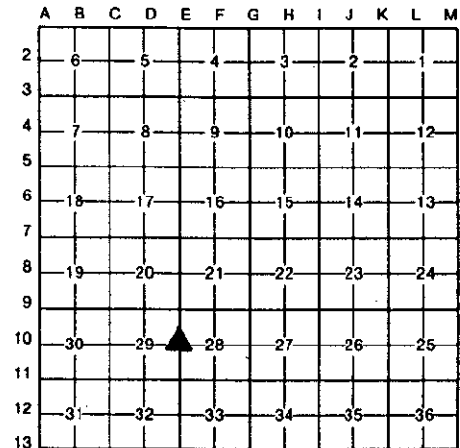

NOTE: Not more than 4 corners, all in the same town and range, may be recorded on this certificate.

A. Description of original monument and accessories and/or subsequent restoration:

E-10 1/4 Corner Between Sections 28 and 29	L.C.R.C. Liber 3, Page 251 (Feb. 14, 1978)
Original gov't corner set in Dec. 1831	Found 1" iron
by Sylvester Sibley	PK in sde P.Pole WSW 59.55'
Set H.W.P.	Nail in sde 10" Maple NW 60.16'
Beech 12" S 80°W 22 links	Nail in sde 22" Ash SW 60.83'
Elm 8" N 08°E 18 links	Nail in sde 26" Maple SE 63.16'

3. Description of corner evidence found and/or method applied in restoring or reestablishing corner:


E-10
 Found 1" iron pipe in Mon. Box in N-S B.T. road (32nd Avenue)
 Found PK nail in NW side P.Pole S64°W 59.51'
 Center of 22" Maple N41°W 59.82'
 Found nail & washer in NE side 30" Maple S39°E 63.15'
 Found nail & washer in SE side 30" Basswood S36°W 60.88'

Accepted as a careful perpetuation of the position of the original corner, and replaced 1" iron pipe with Std. O.C. Cap on 24" x 3/4" iron bar

P.A. 345 OTTAWA COUNTY
PEER APPROVED 11/21/94
Rodney D. Unema

C. Description of monument for corner and accessories established to perpetuate locating the position of the corner:

E-10 1/4 Corner Between Sections 28 and 29	
Std. O.C. Cap on 24" x 3/4" iron bar in Mon. Box	
Set nail & O.C. tag in NE side 22" Maple	N41°W 59.82'
Set nail & O.C. tag in W'ly side 30" Ash	N18°E 95.46'
Set nail & O.C. tag in NE side 30" Maple	S39°E 63.15'
Set nail & O.C. tag in NW side P.Pole	S64°W 59.51'
C/L of N-S B.T. road (32nd Avenue)	West 1'
Set nail & O.C. tag in SE side 30" Basswood	S36°W 60.88'

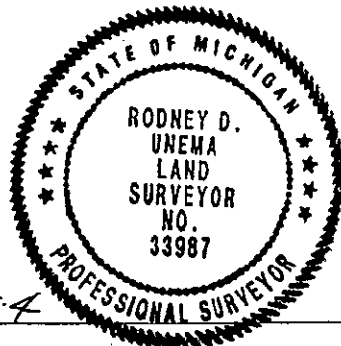

Signed by Rodney D. Unema
 Surveyor's Michigan License No. 33987

Date Nov. 18, 1994