

**SURVEY &
REMONUMENTATION**

APR 25 1995

OTTAWA COUNTY REMONUMENTATION
LAND CORNER RECORDATION CERTIFICATE
Filing Requirement of Act 74, Mich. P.A. 1970

RECORDED

94 DEC -8 PM 12:30

corners in **COMMISSION**

Ottawa
(County)

Located In:
Jamestown Township

Corner Code ##

Public Land Survey	T <u>5N</u> R <u>13W</u>	<u>E-13</u>
	T _____ R _____	_____
	T _____ R _____	_____
	T _____ R _____	_____
Property Controlling in Section	S _____ T _____ R _____	_____
Miscellaneous	S _____ T _____ R _____	_____
Property in Sec.	S _____ T _____ R _____	_____

Reginald Robinson
REGISTER OF DEEDS
OTTAWA COUNTY, MI

Register of Deeds Stamp & File Number

Lot No. _____, Recorded Plat _____
Private Claims _____

Rodney D. Unema, in a field survey on Nov. 16, 19 94,
hereby certify that under requirements of P.A. 74, Michigan P.A. of 1970, the corner points mentioned in lines 1 and 2 above were in conformance with regulations and rules therefore as required in the current manual of survey instructions of the United States Department of the Interior, Bureau of Land Management or by a decree of a Court of Law and/or that the corner points mentioned in lines 3, 4 and 5 above were in conformance with the rules of the Michigan Board of Land Surveyors or by a Decree of a Court of Law; established, re-established, monumented, re-monumented, recovered, found as pressed below:

JTE: Not more than 4 corners, all in the same town and range, may be recorded on this certificate.

	A	B	C	D	E	F	G	H	I	J	K	L	M
2	6	5	4	3	2	1							
3													
4	7	8	9	10	11	12							
5													
6	18	17	16	15	14	13							
7													
8	19	20	21	22	23	24							
9													
10	30	29	28	27	26	25							
11													
12	31	32	33	34	35	36							
13													

Description of original monument and accessories and/or subsequent restoration:
E-13 Corner Common to Sections 32 and 33 on South line of Township ** see other side
Original gov't corner set in L.C.R.C. Liber 3, Page 43 L.C.R.C. Liber 4, Page 160
Oct. 1831, by Lucius Lyon (March, 1976) (April 1, 1981)
Set post Found 1" pipe W edge road Set cast iron Mon.
Beech 14" N67°W 31 links PK in sde T.Pole WNW 54.53' Power pole NE 94.51'
Beech 6" N49°E 47 links SE cor hse NW 84.70' Power pole NW 29.82'
NE cor hse SSW 106.62' Street sign South 26.95'
PK in sde P.Pole NE 63.32' 12" Pine SE 92.46'
Bt. spk S 6.97'

Description of corner evidence found and/or method applied in restoring or reestablishing corner:


E-13
Found 4" dia. cast iron Mon. at intersection of Ottagon and 32nd Avenue
12" below gravel surface
Found nail in SW side P.Pole N47°W 29.78'
Found PK in S'yly side P.Pole N69°E 94.62'
Center of 18" White Pine S70°E 92.63'
SE corner house N56°W 84.62'
Found nail & tag in NE side 40" Willow N60°W 40.18'

Accepted as a careful perpetuation of the position of the original corner.
P.A. 345 OTTAWA COUNTY

PEER APPROVED 11/21/94

Description of monument for corner and accessories established to perpetuate locating the position of the corner:

E-13 Corner Common to Sections 32 and 33 on South line of TOWNSHIP
4" dia. cast iron Mon. at intersection of Ottagon and 32nd Avenue
12" below gravel surface
Set nail & O.C. tag in SW side P.Pole N47°W 29.78'
Set nail & O.C. tag in S'yly side P.Pole N69°E 94.62'
Set nail & O.C. tag in N side 18" White Pine S70°E 92.63'
Set nail & O.C. tag in N side Maple clump S73°W 93.30'
NE corner, Section 5, T4N, R13W (1/2" rerod) East 32.94'

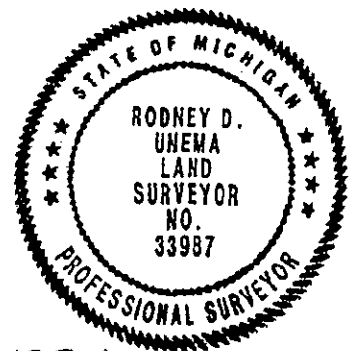

Signed by Rodney D. Unema
Surveyor's Michigan License No. 33987

Date Nov. 18, 1994

OTTAWA

Section A (con't)
L.C.R.C. Liber 3, Page 74
(April 1976)
Found 1" pipe on West edge road
Rd. sign South 26.75'
36" Willow N55°W 41.00'
T.Pole N30°E 63.28'

CODE #
CORNER
CODE #
R339R

120 #
0.00
150 #
2.00