

DEC 01 1993

COMMISSIONER

OTTAWA COUNTY REMONUMENTATION  
LAND CORNER RECORDATION CERTIFICATE  
Filing Requirement of Act 74, Mich. P.A. 1970

RECORDED

93 NOV 11 AM 11:56

*Phyllis Holmstrom*  
REGISTER OF DEEDS  
OTTAWA COUNTY, MI

For corners in

Ottawa

(County)

Located In:

Corner Code #

Jamestown Township

- |                                    |                          |            |
|------------------------------------|--------------------------|------------|
| 1. Public Land Survey              | T <u>5N</u> R <u>13W</u> | <u>F-5</u> |
|                                    | T _____ R _____          | _____      |
|                                    | T _____ R _____          | _____      |
|                                    | T _____ R _____          | _____      |
| 2. Property Controlling in Section | S _____ T _____ R _____  | _____      |
|                                    | S _____ T _____ R _____  | _____      |
| 3. Miscellaneous Property in Sec.  | S _____ T _____ R _____  | _____      |
|                                    | S _____ T _____ R _____  | _____      |

Register of Deeds Stamp & File Number

4. Lot No. \_\_\_\_\_, Recorded Plat \_\_\_\_\_
5. Private Claims \_\_\_\_\_

I, Rodney D. Unema, in a field survey on October 22, 1993, do hereby certify that under requirements of P.A. 74, Michigan P.A. of 1970, the corner points mentioned in lines 1 and 2 above were in conformance with regulations and rules therefore as required in the current manual of survey instructions of the United States Department of the Interior, Bureau of Land Management or by a decree of a Court of Law and/or that the corner points mentioned in lines 3, 4 and 5 above were in conformance with the rules of the Michigan Board of Land Surveyors or by a Decree of a Court of Law; established, re-established, monumented, re-monumented, recovered, found as expressed below:

**NOTE: Not more than 4 corners, all in the same town and range, may be recorded on this certificate.**

A	B	C	D	E	F	G	H	I	J	K	L	M
2	6	5	4	3	2	1						
3												
4	7	8	9	10	11	12						
5												
6	18	17	16	15	14	13						
7												
8	19	20	21	22	23	24						
9												
10	30	29	28	27	26	25						
11												
12	31	32	33	34	35	36						
13												

A. Description of original monument and accessories and/or subsequent restoration:

F-5 1/4 corner between Sections 9 and 16

L.C.R.C. Liber 2, Page 591 (Sept. 1974)

Iron bar

Tel. pole NE 70.18'

C/L conc. post S 22.77'

NE cor. brick house SW 80.66'

L.C.R.C. Liber 2, Page 357 (Nov. 1973)

BT spike

Nail in MBT pole ENE 70.65'

NE cor. brick house SW 80.69'

NW cor. conc. fence post (ILLEGIBLE)

B. Description of corner evidence found and/or method applied in restoring or reestablishing corner:

F-5 Found 1/2" iron pipe in Mon. Box

NE cor. brick house S37°W 80.68'

No other witnesses remaining

Accepted position of 1/2" iron pipe as a careful perpetuation of the position of the original corner.

and replaced 1/2" iron pipe with Std. O.C. cap on 3/4" x 24" iron bar

C. Description of monument for corner and accessories established to perpetuate locating the position of the corner:

F-5 1/4 corner between Sections 9 and 16

Std. O.C. cap on 3/4" x 24" iron bar in Mon. Box


C/L of E-W BT road (Riley) South 0.5'

O.C. tag & nail in S sde of P.Pole S76°E 221.48'

O.C. tag & nail in SW sde of 24" Maple N51°W 97.61'

NE cor. brick house #2810 S37°W 80.68'

O.C. tag & nail in N sde 8" Maple N84°E 272.52'

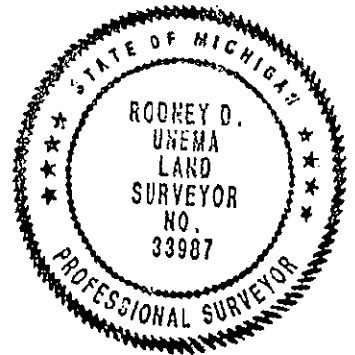

Signed by Rodney D. Unema

Date November 4, 1993

Surveyor's Michigan License No. 33987