

OCT 24 1994

OTTAWA COUNTY REMONUMENTATION  
LAND CORNER RECORDATION CERTIFICATE  
Filing Requirement of Act 74, Mich. P.A. 1970

RECORDED

94 OCT -7 PM 12:33

COMMISSION

For corners in  
Ottawa

(County)

Located In:

Corner Code #

Jamestown Township


- |                                    |   |    |   |     |     |
|------------------------------------|---|----|---|-----|-----|
| 1. Public Land Survey              | T | 5N | R | 13W | F-7 |
|                                    | T |    | R |     |     |
|                                    | T |    | R |     |     |
|                                    | T |    | R |     |     |
| 2. Property Controlling in Section | S |    | T | R   |     |
|                                    | S |    | T | R   |     |
| 3. Miscellaneous Property in Sec.  | S |    | T | R   |     |
|                                    | S |    | T | R   |     |
4. Lot No. \_\_\_\_\_, Recorded Plat \_\_\_\_\_
5. Private Claims \_\_\_\_\_

*Robert D. Unema*  
REGISTER OF DEEDS  
OTTAWA COUNTY, MI

Register of Deeds Stamp & File Number

I, Rodney D. Unema, in a field survey on September 17, 1994, do hereby certify that under requirements of P.A. 74, Michigan P.A. of 1970, the corner points mentioned in lines 1 and 2 above were in conformance with regulations and rules therefore as required in the current manual of survey instructions of the United States Department of the Interior, Bureau of Land Management or by a decree of a Court of Law and/or that the corner points mentioned in lines 3, 4 and 5 above were in conformance with the rules of the Michigan Board of Land Surveyors or by a Decree of a Court of Law; established, re-established, monumented, re-monumented, recovered, found as expressed below:

**NOTE: Not more than 4 corners, all in the same town and range, may be recorded on this certificate.**

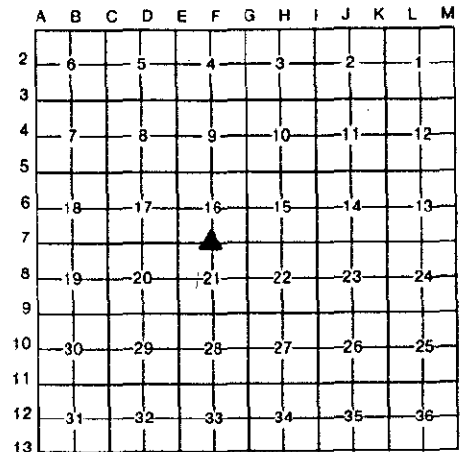

A. Description of original monument and accessories and/or subsequent restoration:

F-7 1/4 Corner between Sections 16 and 21	L.C.R.C. Liber 2, Page 359	L.C.R.C. Liber 5, Page 187
Original gov't corner set in Dec. 1831.	(Nov. 1973)	(Dec. 1984)
by Sylvester Sibley	1/2" solid rod, C/L Byron Rd.	Cast iron monument
Set Sec. Post	"X" on 24" conc pipe NNW 28.43'	Guard post NE 90.95'
Sugar 8" S84°W 19 links	"X" on 24" conc pipe NE 31.57'	Top Center of Corr.
Sugar 16" S72°E 19 links	"X" on 12" conc pipe S 21.50'	Culv. NW 31.07
	"X" on conc pipe SE 29.56'	Top Center of Corr.
		Culv. NE 96.67'

B. Description of corner evidence found and/or method applied in restoring or reestablishing corner:

F-7  
Found 3" dia. C.I.M. in mon. box (6" below top of box) on C/L of Byron Road

Found cut mark on W end 24" conc. culv. N24°W 31.13'  
Found cut mark on E end 24" conc. culv. N18°E 28.83'

\* Accepted as a careful perpetuation of the position of the original corner.


P.A. 345 OTTAWA COUNTY

PEER APPROVED *[Signature]*

C. Description of monument for corner and accessories established to perpetuate locating the position of the corner:

F-7 1/4 Corner Between Sections 16 and 21  
3" dia. cast iron mon. in mon. box (6" below top of box) on C/L of Byron Road (E-W BT road)  
Cut mark on top West end of 24" conc. culv.  
PK & O.C. tag in top East end of 24" conc. culv.  
Nail & O.C. tag in top West end of 24" conc. C.M.P. culv.  
Nail & O.C. tag in top East end of 24" conc. C.M.P. culv.

N24°W 31.13'  
N18°E 28.80'  
S12°W 25.02'  
S43°E 35.74'

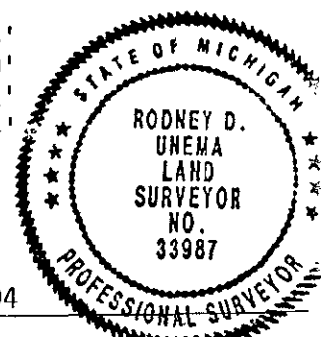

Signed by *Rodney D. Unema*  
Surveyor's Michigan License No. 33987

Date September 19, 1994