

SURVEY & REMONUMENTATION

APR 25 1995

OTTAWA COUNTY REMONUMENTATION

RECORDED

COMMISSION

LAND CORNER RECORDATION CERTIFICATE
Filing Requirement of Act 74, Mich. P.A. 1970

94 DEC -8 PM 12:30

For corners in

Ottawa

(County)

Located In:

Jamestown Township

Corner Code #

1. Public Land Survey	T	5N	R	13W	F-9
	T		R		
	T		R		
	T		R		
2. Property Controlling in Section	S		T	R	
	S		T	R	
3. Miscellaneous Property in Sec.	S		T	R	
	S		T	R	

Robert Chittenden
REGISTER OF DEEDS
OTTAWA COUNTY, MI

Register of Deeds Stamp & File Number

4. Lot No. _____, Recorded Plat _____
5. Private Claims _____

	A	B	C	D	E	F	G	H	I	J	K	L	M
2	6	5	4	3	2	1							
3													
4	7	8	9	10	11	12							
5													
6	18	17	16	15	14	13							
7													
8	19	20	21	22	23	24							
9													
10	30	29	28	27	26	25							
11													
12	31	32	33	34	35	36							
13													

Rodney D. Unema, in a field survey on Nov. 16, 19 94, do hereby certify that under requirements of P.A. 74, Michigan P.A. of 1970, the corner points mentioned in lines 1 and 2 above were in conformance with regulations and rules therefore as required in the current manual of survey instructions of the United States Department of the Interior, Bureau of Land Management or by a decree of a Court of Law and/or that the corner points mentioned in lines 3, 4 and 5 above were in conformance with the rules of the Michigan Board of Land Surveyors or by a Decree of a Court of Law; established, re-established, monumented, re-monumented, recovered, found as expressed below:

NOTE: Not more than 4 corners, all in the same town and range, may be recorded on this certificate.

A. Description of original monument and accessories and/or subsequent restoration:

F-9 1/4 Corner Between Sections 21 and 28
Original gov't corner set in Dec. 1831 by Sylvester Sibley
Set 1/4 Section Post
Beech 8" S56°E 12 links
W. Ash 6" N86°W 20 links

L.C.R.C. Liber 1, Page 737
(Nov. 21, 1972)
Found 3/4" solid iron
Bt. spk in 28" Walnut N 21.67'
Bt. spk in 14" Walnut NE 35.45'
Nail in T.Pole ESE 42.61'
Nail in T.Pole NW 71.94'
Center street sign post SE 33.95'

** see other side
L.C.R.C. Liber 2, Pg. 387
(Nov. 26, 1973)
1/2" iron
Sq. spk in sde 24" Walnut N 21.67'
PK nail in side T.Pole SE 42.60'
PK nail in side T.Pole NW 71.95'

3. Description of corner evidence found and/or method applied in restoring or reestablishing corner:

F-9
Found cast iron Mon. (top broken off) in Mon. Box
C/L of E-W B.T. road
C/L of gravel road to South
Found nail in SW side P.Pole (cut off)
Center of street sign

North 1'
East 6'
N44°W 71.01'
S35°W 40.78'

No other witnesses remaining

Accepted as a careful perpetuation of the position of the original corner.
P.A. 345 OTTAWA COUNTY


PEER APPROVED 11/21/94

Rodney D. Unema

C. Description of monument for corner and accessories established to perpetuate locating the position of the corner:

F-9 1/4 Corner Between Sections 21 and 28
Center of Cast Iron Mon. (top broken off) in Mon. Box
Set nail & O.C. tag in SW side of P.Pole (cut off)
Set nail & O.C. tag in E end of 12" CMP culv.
Set nail & O.C. tag in E end of 24" CMP culv.
Set nail & O.C. tag in W end of 24" CMP culv.
C/L of E-W BT road (Perry St.)
C/L of gravel road (28th Ave.) to South

N44°W 71.01'
N22°E 29.23'
S44°E 37.20'
S38°W 34.59'
North 1'
East 6'

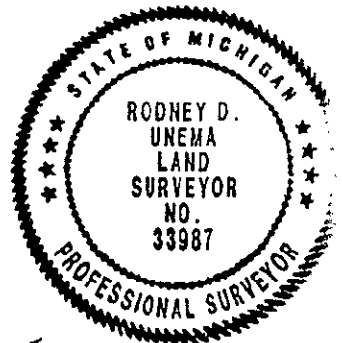

Signed by Rodney D. Unema
Surveyor's Michigan License No. 33987

Date Nov. 18, 1994

OTTAWA

Section A (con't)
F-9 L.C.R.C. Liber 4, Page 208 (June 25, 1981)
Set Cast Iron Mon.
20" tree NE 35.54'
Fence post SW 36.07'
Power pole NW 71.07'
31" tree North 21.67'
C/L gravel road North 4.0'

REMON LIBER # 3800
PAGE # 423
0016
150
0016
150
0016
150