

SURVEY & REMONUMENTATION

APR 25 1995

OTTAWA COUNTY REMONUMENTATION

LAND CORNER RECORDATION CERTIFICATE
Filing Requirement of Act 74, Mich. P.A. 1970

RECORDED

94 DEC -8 PM 12:30

For corners in COMMISSION
Ottawa
(County)

Located In: Jamestown Township Corner Code #

Richard Kullman
REGISTER OF DEEDS
OTTAWA COUNTY, MI

- | | | | |
|---------------------------------------|--------------------------|-------|-------|
| 1. Public Land Survey | T <u>5N</u> R <u>13W</u> | F-13 | |
| | T _____ R _____ | _____ | _____ |
| | T _____ R _____ | _____ | _____ |
| | T _____ R _____ | _____ | _____ |
| 2. Property Controlling in Section | S _____ T _____ R _____ | _____ | _____ |
| | S _____ T _____ R _____ | _____ | _____ |
| 3. Miscellaneous Property in Sec. | S _____ T _____ R _____ | _____ | _____ |
| | S _____ T _____ R _____ | _____ | _____ |
| 4. Lot No. _____, Recorded Plat _____ | | | |
| 5. Private Claims _____ | | | |

Register of Deeds Stamp & File Number

I, Rodney D. Unema, in a field survey on Nov. 16, 1994, do hereby certify that under requirements of P.A. 74, Michigan P.A. of 1970, the corner points mentioned in lines 1 and 2 above were in conformance with regulations and rules therefore as required in the current manual of survey instructions of the United States Department of the Interior, Bureau of Land Management or by a decree of a Court of Law and/or that the corner points mentioned in lines 3, 4 and 5 above were in conformance with the rules of the Michigan Board of Land Surveyors or by a Decree of a Court of Law; established, re-established, monumented, re-monumented, recovered, found as expressed below:

| | | | | | | | | | | | | | |
|----|----|----|----|----|----|----|---|---|---|---|---|---|---|
| | A | B | C | D | E | F | G | H | I | J | K | L | M |
| 2 | 6 | 5 | 4 | 3 | 2 | 1 | | | | | | | |
| 3 | | | | | | | | | | | | | |
| 4 | 7 | 8 | 9 | 10 | 11 | 12 | | | | | | | |
| 5 | | | | | | | | | | | | | |
| 6 | 13 | 17 | 16 | 15 | 14 | 13 | | | | | | | |
| 7 | | | | | | | | | | | | | |
| 8 | 19 | 20 | 21 | 22 | 23 | 24 | | | | | | | |
| 9 | | | | | | | | | | | | | |
| 10 | 30 | 29 | 28 | 27 | 26 | 25 | | | | | | | |
| 11 | | | | | | | | | | | | | |
| 12 | 31 | 32 | 33 | 34 | 35 | 36 | | | | | | | |
| 13 | | | | | | | | | | | | | |

NOTE: Not more than 4 corners, all in the same town and range, may be recorded on this certificate.

A. Description of original monument and accessories and/or subsequent restoration:

| | |
|---|---|
| F-13 S 1/4 Corner, Section 33 Original gov't corner set in Oct. 1831 by Lucius Lyon Set H.W.P. Beech 10" N77°E 21 links Beech 14" N45°W 28 links | L.C.R.C. Liber 4, Page 143 (Jan. 26, 1981) 1/2" rebar Spk on NE side 38" Maple SE 56.24' Spk on NE side 24" Hickory WNW 151.41' NW cor. garage WSW 212.0' |
|---|---|

B. Description of corner evidence found and/or method applied in restoring or reestablishing corner:


F-13
 Found 1/2" rerod + on C/L of E-W gravel road
 Found spk in NE side 36" Maple S50°E 56.21'
 Found spk in S side 24" Hickory N70°W 151.46'

Accepted as a careful perpetuation of the position of the original corner, and replaced 1/2" rerod with Std. O.C. Cap on 24" x 3/4" iron bar.

P.A. 345 OTTAWA COUNTY
 PEER APPROVED 11/21/94
Rodney D. Unema

C. Description of monument for corner and accessories established to perpetuate locating the position of the corner:

| | |
|--|---|
| F-13 S 1/4 Corner, Section 33 Std. O.C. Cap on 24" x 3/4" iron bar (6" below gravel surface) on C/L of E-W gravel road (Ottagon St.) Set nail & O.C. tag in S side 24" Hickory Set nail & O.C. tag in W side 10" Maple Set nail & O.C. tag in NE side 36" Maple SE corner brick house N 1/4 corner, Section 4, T4N, R13W (Capped griffin iron) | N70°W 151.46' N00°E 56.35' S51°E 56.19' S41°W 161.95' East 75.43' |
|--|---|

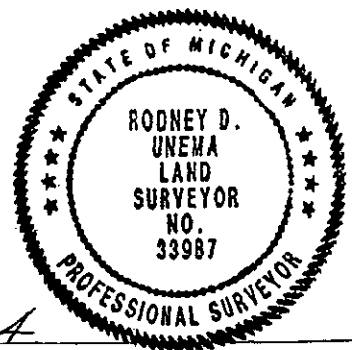

Signed by *Rodney D. Unema*
 Surveyor's Michigan License No. 33987

Date NOV. 18, 1994