


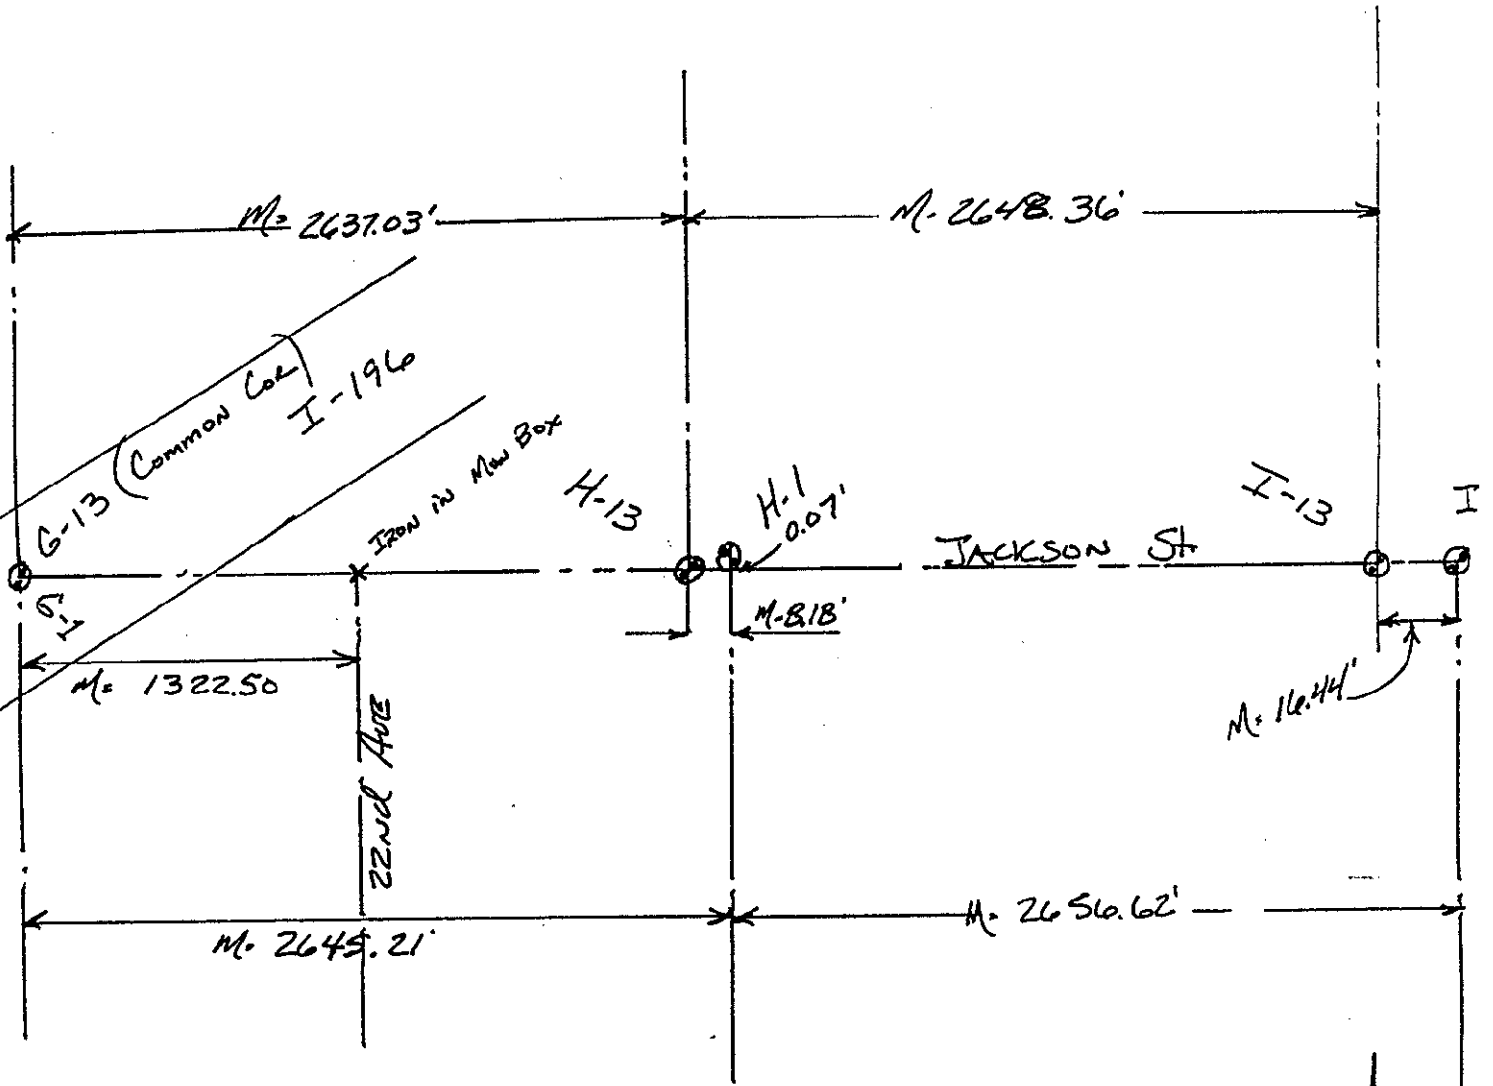

FEB 24 2000

SECTION

Section 34 - Georgetown Twp.



Section 3, Jamestown Twp.