

REMONUMENTATION

DEC 01 1993

OTTAWA COUNTY REMONUMENTATION
 COMMISSION LAND CORNER RECORDATION CERTIFICATE
 Filing Requirement of Act 74, Mich. P.A. 1970

RECORDED
 93 NOV 11 AM 11:56


Rodney D. Unema
 REGISTER OF DEEDS
 OTTAWA COUNTY, MI

For corners in

<u>Ottawa</u> (County)	Located In:	Corner Code #
	Jamestown Township	
1. Public Land Survey	T <u>5N</u> R <u>13W</u>	<u>G-4</u>
	T _____ R _____	_____
	T _____ R _____	_____
	T _____ R _____	_____
2. Property Controlling in Section	S _____ T _____ R _____	_____
	S _____ T _____ R _____	_____
3. Miscellaneous Property in Sec.	S _____ T _____ R _____	_____
	S _____ T _____ R _____	_____
4. Lot No. _____, Recorded Plat _____		
5. Private Claims _____		

Register of Deeds Stamp & File Number

I, Rodney D. Unema, in a field survey on October 22, 19 93, do hereby certify that under requirements of P.A. 74, Michigan P.A. of 1970, the corner points mentioned in lines 1 and 2 above were in conformance with regulations and rules therefore as required in the current manual of survey instructions of the United States Department of the Interior, Bureau of Land Management or by a decree of a Court of Law and/or that the corner points mentioned in lines 3, 4 and 5 above were in conformance with the rules of the Michigan Board of Land Surveyors or by a Decree of a Court of Law; established, re-established, monumented, re-monumented, recovered, found as expressed below:

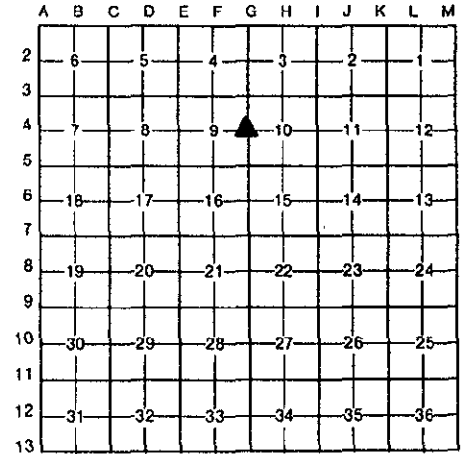

NOTE: Not more than 4 corners, all in the same town and range, may be recorded on this certificate.

A. Description of original monument and accessories and/or subsequent restoration:


G-4 1/4 corner between Sections 9 and 10
 L.C.R.C. Liber 2, Page 357 (Nov. 1973)
 c/4" solid iron
 Nail in MBT Pole WNW 55.37'
 Nail in P.Pole SW 53.00'
 Nail in P.Pole SE 85.53'
 NW cor. hse. fndn. ENE 40.56'

B. Description of corner evidence found and/or method applied in restoring or reestablishing corner:

G-4 Found 3/4" solid iron in Mon. Box at intersection of Greenly St. and 24th Ave.
 Found PK nail in NW sde of P.Pole S46°W 50.84'
 C/L P.Pole (cut off) S46°W 53.0'
 No other witnesses remaining
 Accepted position of 3/4" iron as a careful perpetuation of the position of the original corner
 and replaced 3/4" iron with 3/4" x 24" iron bar with Std. O.C. Cap.

C. Description of monument for corner and accessories established to perpetuate locating the position of the corner:

G-4 1/4 corner between Sections 9 and 10
 Std. O.C. cap on 3/4" x 24" iron bar in Mon. Box
 at intersection of Greenly St. and 24th Ave.
 O.C. tag & nail in SW sde 24" Ash S45°E 59.05'
 O.C. tag & nail in W sde Service Pole S16°E 101.57'
 O.C. tag & nail in NW sde P.Pole S46°W 50.99'
 O.C. tag & nail in SW sde Pear tree N29°W 87.90'

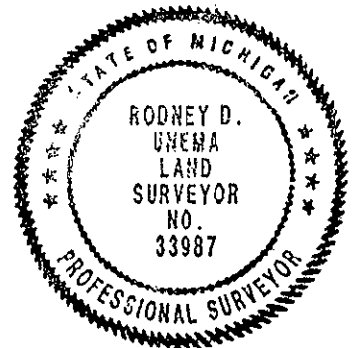

Signed by *Rodney D. Unema* Date November 4, 1993
 Surveyor's Michigan License No. 33987

FORM APPROVED BY MICHIGAN STATE BOARD OF LAND SURVEYORS, JAN. 28, 1971
 REVISED MAY 14, 1975
 REVISED JAN., 1993