

SURVEY & REMONUMENTATION

OTTAWA COUNTY REMONUMENTATION

RECORDED

DEC 01 1993

LAND CORNER RECORDATION CERTIFICATE 93 NOV 11 AM 11:56

Filing Requirement of Act 74, Mich. P.A. 1970

For corners in Commission
Ottawa
(County)

Located In: Jamestown Township Corner Code # G-5
T 5N R 13W
T _____ R _____
T _____ R _____
T _____ R _____
S _____ T _____ R _____
S _____ T _____ R _____
S _____ T _____ R _____
S _____ T _____ R _____

Rodney D. Unema
REGISTER OF DEEDS
OTTAWA COUNTY, MI

Register of Deeds Stamp & File Number

4. Lot No. _____, Recorded Plat _____
5. Private Claims _____

A	B	C	D	E	F	G	H	I	J	K	L	A
2	6	5	4	3	2	1						
3												
4	7	8	9	10	11	12						
5												
6	18	17	16	15	14	13						
7												
8	19	20	21	22	23	24						
9												
10	30	29	28	27	26	25						
11												
12	31	32	33	34	35	36						
13												

I, Rodney D. Unema, in a field survey on October 22, 19 93, do hereby certify that under requirements of P.A. 74, Michigan P.A. of 1970, the corner points mentioned in lines 1 and 2 above were in conformance with regulations and rules therefore as required in the current manual of survey instructions of the United States Department of the Interior, Bureau of Land Management or by a decree of a Court of Law and/or that the corner points mentioned in lines 3, 4 and 5 above were in conformance with the rules of the Michigan Board of Land Surveyors or by a Decree of a Court of Law; established, re-established, monumented, re-monumented, recovered, found as expressed below:

NOTE: Not more than 4 corners, all in the same town and range, may be recorded on this certificate.

A. Description of original monument and accessories and/or subsequent restoration:

G-5 Corner common to Sections 9, 10, 15 and 16


L.C.R.C. Liber 6, Pg. 172 (Oct. 1991)	L.C.R.C. Liber 2, Pg. 591 (Sept. 1991)	L.C.R.C. Liber 2, Pg. 73 (Nov. 1973)
Cast iron Mon. in Mon. Box	Iron bar	3/4" solid rod
Guy pole PK nail NE 44.57'	C/L street sign SE 46.13'	SW cor. brick (bank) bldg NE 53.23'
22" Chinese Elm SE 47.62'	SW cor. brk. bank NE 53.24'	Face of st. sign post SE 46.00'
Power pole PK nail SW 37.63'	SE cor. post off. NW 49.84'	NE cor. bldg. SW 51.90'
Bldg. cor. NW 49.82'	NE cor. store SW 51.92'	SE cor. bottom step NW 45.20'

B. Description of corner evidence found and/or method applied in restoring or reestablishing corner:

G-5 Found 3" dia. cast iron Mon. in Mon. Box at intersection of 24th Ave. and Riley St.
30" Chinese Elm (no nail found) S43°E 47'
Found PK nail in NW sde of P.Pole S48°W 37.62'
Found PK nail in SE sde of Service Pole N60°E 44.56'
SE cor. of brick bldg. N40°W 49.82'

C. Description of monument for corner and accessories established to perpetuate locating the position of the corner:

G-5 Corner common to Sections 9, 10, 15 and 16
3" dia. cast iron Mon. in Mon. Box at intersection of 24th Ave. and Riley St. (BT roads)
O.C. tag & nail in NW sde of 30" Chinese Elm S43°E 47.05'
O.C. tag & nail in NW sde of P.Pole S48°W 37.61'
O.C. tag & nail in SE sde of Service Pole N60°E 44.56'
SE cor. of brick bldg. N40°W 49.82'

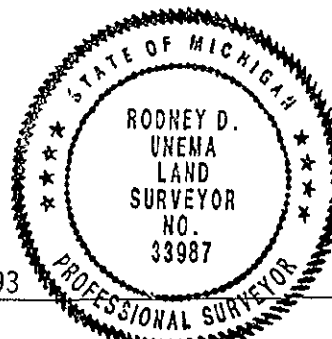

Signed by Rodney D. Unema Date November 4, 1993
Surveyor's Michigan License No. 33987