

SURVEY & REMONUMENTATION

APR 25 1995

OTTAWA COUNTY REMONUMENTATION LAND CORNER RECORDATION CERTIFICATE Filing Requirement of Act 74, Mich. P.A. 1970

RECORDED

94 DEC -8 PM 12: 30


For corners in **COMMISSION**

<u>Ottawa</u> <small>(County)</small>	Located In: <u>Jamestown Township</u>	Corner Code # <u>G-9</u>
1. Public Land Survey	T <u>5N</u> R <u>13W</u>	<u>G-9</u>
	T _____ R _____	_____
	T _____ R _____	_____
	T _____ R _____	_____
2. Property Controlling in Section	S _____ T _____ R _____	_____
	S _____ T _____ R _____	_____
3. Miscellaneous Property in Sec.	S _____ T _____ R _____	_____
	S _____ T _____ R _____	_____
4. Lot No. _____, Recorded Plat _____		
5. Private Claims _____		

Phyllis Kullman
REGISTER OF DEEDS
OTTAWA COUNTY, MI

Register of Deeds Stamp & File Number

I, Rodney D. Unema, in a field survey on Nov. 16, 19 94, do hereby certify that under requirements of P.A. 74, Michigan P.A. of 1970, the corner points mentioned in lines 1 and 2 above were in conformance with regulations and rules therefore as required in the current manual of survey instructions of the United States Department of the Interior, Bureau of Land Management or by a decree of a Court of Law and/or that the corner points mentioned in lines 3, 4 and 5 above were in conformance with the rules of the Michigan Board of Land Surveyors or by a Decree of a Court of Law; established, re-established, monumented, re-monumented, recovered, found as expressed below:

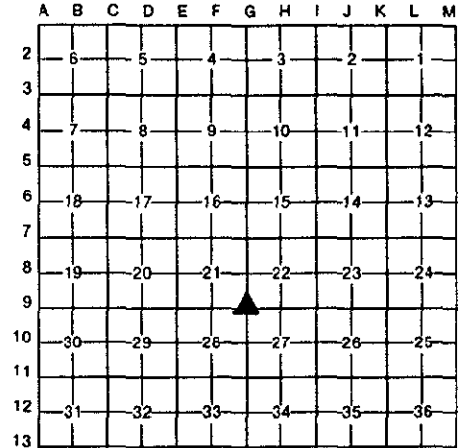

NOTE: Not more than 4 corners, all in the same town and range, may be recorded on this certificate.

A. Description of original monument and accessories and/or subsequent restoration:

G-9 Corner Common to Sections 21, 22, 27 and 28	L.C.R.C. Liber 1, Page 737 (Nov. 21, 1972)
Original gov't corner set in Dec. 1831,	Bt. spike in Mon. Box
by Sylvester Sibley	Nail in T.Pole NNW 50.50'
Set post	Nail in T.Pole SW 47.67'
W. Ash 7" N36°W 7 links	Nail in guy pole NE 50.00'
Butternut 14" S18°E 11 links	Center street sign post SE 33.95'

B. Description of corner evidence found and/or method applied in restoring or reestablishing corner:

G-9	Found bolt spike in Mon. Box at intersection of 24th Avenue and Perry Street
	Found PK nail in SE side of P.Pole N44°E 69.80'
	Found PK nail in N side of T.Pole (cut off) S78°E 88.60'
	Found spike in SE side twin 8" Ash S60°W 52.99'

Accepted as a careful perpetuation of the position of the original corner, and replaced bolt spike with Std. O.C. cap on 24" x 3/4" iron bar

Rodney D. Unema
P.A. 345 OTTAWA COUNTY
PEER APPROVED 11/21/94

C. Description of monument for corner and accessories established to perpetuate locating the position of the corner:

G-9 Corner Common to Sections 21, 22, 27 and 28	
Std. O.C. Cap on 24" x 3/4" iron bar in Mon. Box at intersection of 24th Ave. and Perry St.	
Set nail & O.C. tag in SW side P.Pole	N27°W 64.90'
Set nail & O.C. tag in SE side P.Pole	N44°E 69.80'
Set nail & O.C. tag in N side T.Pole (cut off)	S78°E 88.60'
Set nail & O.C. tag in SE side twin 8" Ash	S60°W 52.99'
C/L of N-S B.T. road (24th Avenue)	West 2.5'
on C/L of B.T. road to West	



Signed by Rodney D. Unema
Surveyor's Michigan License No. 33987

Date Nov. 18, 1994