

SURVEY & REMONUMENTATION

APR 25 1995

OTTAWA COUNTY REMONUMENTATION
LAND CORNER RECORDATION CERTIFICATE
 Filing Requirement of Act 74, Mich. P.A. 1970

RECORDED

94 DEC -8 PM 12: 29

For corners in **COMMISSION**
Ottawa
(County)


Located In: Jamestown Township Corner Code #
G-11

1. Public Land Survey	T <u>5N</u> R <u>13W</u>	<u> </u>
	T <u> </u> R <u> </u>	<u> </u>
	T <u> </u> R <u> </u>	<u> </u>
	T <u> </u> R <u> </u>	<u> </u>
2. Property Controlling in Section	S <u> </u> T <u> </u> R <u> </u>	<u> </u>
	S <u> </u> T <u> </u> R <u> </u>	<u> </u>
3. Miscellaneous Property in Sec.	S <u> </u> T <u> </u> R <u> </u>	<u> </u>
	S <u> </u> T <u> </u> R <u> </u>	<u> </u>

D. J. Kellerman
 REGISTER OF DEEDS
 OTTAWA COUNTY, MI

Register of Deeds Stamp & File Number

4. Lot No. , Recorded Plat
 5. Private Claims

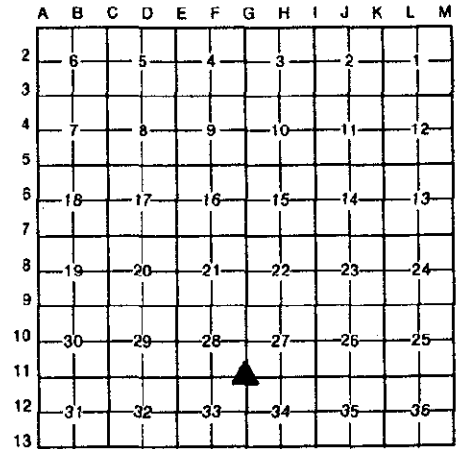

I, Rodney D. Unema, in a field survey on Nov. 16, 19 94, do hereby certify that under requirements of P.A. 74, Michigan P.A. of 1970, the corner points mentioned in lines 1 and 2 above were in conformance with regulations and rules therefore as required in the current manual of survey instructions of the United States Department of the Interior, Bureau of Land Management or by a decree of a Court of Law and/or that the corner points mentioned in lines 3, 4 and 5 above were in conformance with the rules of the Michigan Board of Land Surveyors or by a Decree of a Court of Law; established, re-established, monumented, re-monumented, recovered, found as expressed below:

NOTE: Not more than 4 corners, all in the same town and range, may be recorded on this certificate.

A. Description of original monument and accessories and/or subsequent restoration:

G-11 Corner Common to Sections 27, 28, 33 and 34
 Original gov't corner set in Dec. 1831 by Sylvester Sibley
 Set post
 Beech 6" N26°W 22 links
 Hemlock 20" S32°E 47 links

L.C.R.C. Liber 5, Page 194 (Dec. 27, 1984)
 Set Cast Iron Mon.
 Power pole NW 83.18'
 Power pole NE 77.17'
 Power pole SW 103.55'
 Power pole SE 82.07'

B. Description of corner evidence found and/or method applied in restoring or reestablishing corner:

G-11
 Found 3" dia. cast iron Mon. in Mon. Box at intersection of Adams St. and 24th Ave.
 Found PK nail in W side of P.Pole N55°W 48.75'
 Found PK nail in NW side of P.Pole N54°E 77.19'
 Found PK nail in N side of P.Pole S56°E 82.08'
 Found nail & tag in E side of P.Pole S18°W 103.61'


Accepted as a careful perpetuation of the position of the original corner.

P.A. 345 OTTAWA COUNTY

PEER APPROVED 11/21/94
Rodney D. Unema

C. Description of monument for corner and accessories established to perpetuate locating the position of the corner:

G-11 Corner Common to Sections 27, 28, 33 and 34
 3" dia. cast iron Mon. in Mon. Box
 At intersection (C/L "X") of Adams Street and 24th Avenue
 Set nail & O.C. tag in SW side of P.Pole N55°W 48.75'
 Set nail & O.C. tag in NW side of P.Pole N54°E 77.19'
 Set nail & O.C. tag in N side of P.Pole S56°E 82.08'
 Set nail & O.C. tag in E side of P.Pole S18°W 103.61'

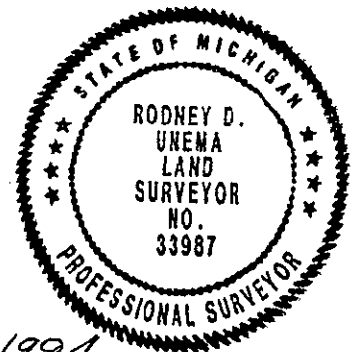

Signed by Rodney D. Unema Date Nov. 18, 1994

Surveyor's Michigan License No. 33987