

**SURVEY &
REMONUMENTATION**

APR 05 1996

COMMISSION

OTTAWA COUNTY REMONUMENTATION
LAND CORNER RECORDATION CERTIFICATE
Filing Requirement of Act 74, Mich. P.A. 1970

For corners in

Ottawa (County)	Located In: Jamestown Township	Corner Code ##
1. Public Land Survey	T <u>5N</u> R <u>13W</u>	<u>H-5</u>
	T _____ R _____	_____
	T _____ R _____	_____
	T _____ R _____	_____
2. Property Controlling in Section	S _____ T _____ R _____	_____
	S _____ T _____ R _____	_____
3. Miscellaneous Property in Sec.	S _____ T _____ R _____	_____
	S _____ T _____ R _____	_____

RECORDED

95 NOV 29 PM 1:47

Roger D. Unema
REGISTER OF DEEDS
OTTAWA COUNTY, MI

Register of Deeds Stamp & File Number

4. Lot No. _____, Recorded Plat _____
5. Private Claims _____

I, Rodney D. Unema, in a field survey on October 13, 19 95, do hereby certify that under requirements of P.A. 74, Michigan P.A. of 1970, the corner points mentioned in lines 1 and 2 above were in conformance with regulations and rules therefore as required in the current manual of survey instructions of the United States Department of the Interior, Bureau of Land Management or by a decree of a Court of Law and/or that the corner points mentioned in lines 3, 4 and 5 above were in conformance with the rules of the Michigan Board of Land Surveyors or by a Decree of a Court of Law; established, re-established, monumented, re-monumented, recovered, found as expressed below:

	A	B	C	D	E	F	G	H	I	J	K	L
2	6	5						3		2		1
3												
4	7	8	9					10		11		12
5												
6	18	17	16					15		14		13
7												
8	19	20	21					22		23		24
9												
10	30	29	28					27		26		25
11												
12	31	32	33					34		35		36
13												

NOTE: Not more than 4 corners, all in the same town and range, may be recorded on this certificate.

A. Description of original monument and accessories and/or subsequent restoration:

H-5 1/4 corner between Sections 10 and 15 *Over
Dec, 1831 original govt LCRC Lib. 2, Pg 641 (Oct. 1974)
corner set by Sylvester Sibley R.R. spike in mon. box
Set post T.P. NNE 30.23'
7" Sugar N75°W 41 links T.P. S 42.08'
8" Beech S57°E 37 links

LCRC Lib. 4, Pg 101 (Sept. 198
R.R. spike in mon. box
NW cor. brick gar hse #2000
S 85.23'
PK in W sde P. Pole N 30.19'
NE cor. brick gar hse #2004
SW 108.13'
NE cor. hse #2000 SE 99.41'

B. Description of corner evidence found and/or method applied in restoring or reestablishing corner:

H-5 Found 4" diameter cast iron monument in monument box (4" below top of box)
Mon. is on ϕ of Riley Street
Found PK nail in W side P. Pole S15°W 42.91'
22" Maple S21°W 85.0' to center
Found nail in S side fence post N15°W 34.24'
Found nail in S side fence post N75°E 96.85'
NE corner brick garage (house #2004) S30°W 108.15'
NW corner brick garage (house #2000) S06°W 85.38'


PA. 345 OTTAWA COUNTY
PEER APPROVED 11-20-95

Rodney D. Unema
R.D.U.

Accepted as a careful perpetuation of the position of the original corner.

C. Description of monument for corner and accessories established to perpetuate locating the position of the corner:

H-5 1/4 corner between Sections 10 and 15
4" diameter cast iron monument in monument box (4" below top of box) on ϕ of Riley Street
Set nail and OC tag in W side P. Pole S15°W 42.91'
NE corner brick garage house #2004 S30°W 108.15'
NW corner brick garage house #2000 S06°W 85.38'
Set nail and OC tag in S side 12" Ash N75°E 145.08'

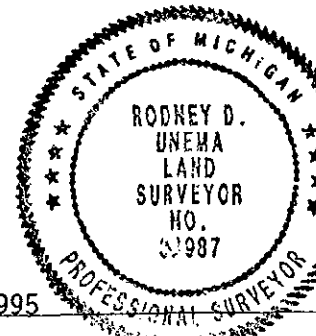

Signed by Rodney D. Unema
Surveyor's Michigan License No. 33987

Date November 20, 1995

FORM APPROVED BY MICHIGAN STATE BOARD OF LAND SURVEYORS, JAN. 28, 1971
REVISED MAY 14, 1971
REVISED JAN., 1991

H-5
LCRC Lib. 5, Page 73 (Dec., 1983)
Set cast iron monument in monument box
PP S 42.51'
18" Maple SSW 84.94'
Fence post NNW 34.35'
Cor. fence post NE 96.69'

\$ 11.00 CORNER