

SURVEY & REMONUMENTATION

APR 05 1996

OTTAWA COUNTY REMONUMENTATION LAND CORNER RECORDATION CERTIFICATE Filing Requirement of Act 74, Mich. P.A. 1970

COMMISSION

For corners in
OTTAWA
(County)

Located In: Jamestown Township Corner Code H-9

1. Public Land Survey	T	<u>5N</u>	R	<u>13W</u>	<u>H-9</u>
	T		R		
	T		R		
	T		R		
2. Property Controlling in Section	S		T		R
	S		T		R
3. Miscellaneous Property in Sec.	S		T		R
	S		T		R

RECORDED

95 NOV 15 PM 2: 11

Polycia Ballman
REGISTER OF DEEDS
OTTAWA COUNTY, MI

Register of Deeds Stamp & File Number

4. Lot No. _____, Recorded Plat _____
5. Private Claims _____

	A	B	C	D	E	F	G	H	I	J	K	L	M
2	6	5	4	3	2	1							
3													
4	7	8	9	10	11	12							
5													
6	18	17	16	15	14	13							
7													
8	19	20	21	22	23	24							
9													
10	30	29	28	27	26	25							
11													
12	31	32	33	34	35	36							
13													

I, Rodney D. Unema, in a field survey on October 12, 19 95, do hereby certify that under requirements of P.A. 74, Michigan P.A. of 1970, the corner points mentioned in lines 1 and 2 above were in conformance with regulations and rules therefore as required in the current manual of survey instructions of the United States Department of the Interior, Bureau of Land Management or by a decree of a Court of Law and/or that the corner points mentioned in lines 3, 4 and 5 above were in conformance with the rules of the Michigan Board of Land Surveyors or by a Decree of a Court of Law, established, re-established, monumented, re-monumented, recovered, found as expressed below:

NOTE: Not more than 4 corners, all in the same town and range, may be recorded on this certificate.

A. Description of original monument and accessories and/or subsequent restoration:

H-9 1/4 corner between Sections 22 and 27	LCRC Lib 3, Pg 113 (10/76)	Liber 3 of Surveys, Pg 306 (5/77)
Dec 1831 original gov't corner set by Sylvester Sibley	Found large "T" iron	Steel "T" fence post
Set post	Nail in T Pole N 28.60'	PK in S'yly sde G. Pole WNW 54.88'
6" Beech S65°E 14 links	Nail in G Pole ENE 54.35'	PK in SW sde P. Pole SE 73.06'
7" W. Ash N9°W 17 links	Nail in P Pole SE 72.50'	PK in NW sde P. Pole SW 110.12'
	Nail in P Pole WSW 109.70'	Nail & washer in W sde 12" Maple N 107.31'

B. Description of corner evidence found and/or method applied in restoring or reestablishing corner:

H-9 Found bent rebar in gravel road/found large "T" iron below rebar - 16" below
 Found PK nail in SE sde guy pole N75°E 55.03'
 Found PK nail in SW sde P. Pole S42°E 73.06'
 Found PK nail in N'yly sde P. Pole S65°W 110.12'
 On ϕ of gravel road to South (20th Avenue) South 4.0'
 ϕ of E-W gravel road (Perry Street) North 32.95'
 Found N & J iron

PA. 345 OTTAWA COUNTY


PEER APPROVED 10/23/95

Rodney D. Unema
M.P.S.

Accepted "T" iron as a careful perpetuation of the position of the original corner and placed standard Ottawa County Remon cap on 3/4" x 24" iron bar over "T" iron.

C. Description of monument for corner and accessories established to perpetuate locating the position of the corner:

H-9 1/4 corner between Sections 22 and 27
 Standard OC cap on 3/4" x 24" iron bar (8" below gravel surface)
 On ϕ gravel road to South (20th Avenue)
 Set Nail & OC tag in W sde guy pole N01°W 35.34'
 Set nail & OC tag in SE sde guy pole N75°E 55.05'
 Set nail & OC tag in SW sde P. Pole S42°E 73.06'
 Set nail ϕ OC tag in SE sde P. Pole S65°W 110.12'
 ϕ of E-W gravel road (Perry Street) South 4.0'

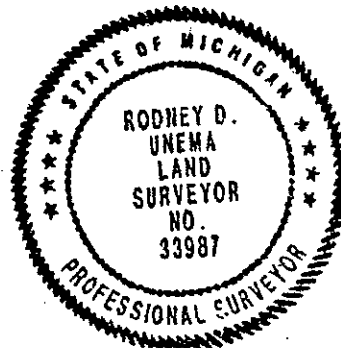

Signed by Rodney D. Unema

Date October 20, 1995

Surveyor's Michigan License No. 33987