

**SURVEY &
REMONUMENTATION**

APR 05 1996

COMMISSION

**OTTAWA COUNTY REMONUMENTATION
LAND CORNER RECORDATION CERTIFICATE
Filing Requirement of Act 74, Mich. P.A. 1970**

For corners in
OTTAWA
(County)

Located In: Jamestown Township Corner Code #H-11

- | | | |
|------------------------------------|--------------------------|-------------|
| 1. Public Land Survey | T <u>5N</u> R <u>13W</u> | <u>H-11</u> |
| | T _____ R _____ | _____ |
| | T _____ R _____ | _____ |
| | T _____ R _____ | _____ |
| 2. Property Controlling in Section | S _____ T _____ R _____ | _____ |
| | S _____ T _____ R _____ | _____ |
| 3. Miscellaneous Property in Sec. | S _____ T _____ R _____ | _____ |
| | S _____ T _____ R _____ | _____ |

RECORDED

95 NOV 15 PM 2:14

Royce A. Redmond
REGISTER OF DEEDS
OTTAWA COUNTY, MI

Register of Deeds Stamp & File Number

4. Lot No. _____, Recorded Plat _____
5. Private Claims _____

I, Rodney D. Unema, in a field survey on October 13, 1995, do hereby certify that under requirements of P.A. 74, Michigan P.A. of 1970, the corner points mentioned in lines 1 and 2 above were in conformance with regulations and rules therefore as required in the current manual of survey instructions of the United States Department of the Interior, Bureau of Land Management or by a decree of a Court of Law and/or that the corner points mentioned in lines 3, 4 and 5 above were in conformance with the rules of the Michigan Board of Land Surveyors or by a Decree of a Court of Law; established, re-established, monumented, re-monumented, recovered, found as expressed below:

NOTE: Not more than 4 corners, all in the same town and range, may be recorded on this certificate.

	A	B	C	D	E	F	G	H	I	J	K	L	M
2	6	5	4	3	2	1							
3													
4	7	8	9	10	11	12							
5													
6	13	17	16	15	14	13							
7													
8	19	20	21	22	23	24							
9													
10	30	29	28	27	26	25							
11													
12	31	32	33	34	35	36							
13													

A. Description of original monument and accessories and/or subsequent restoration:

H-11 1/4 corner between Sections 27 and 34	LCRC Lib 1, Pg 635 (9/72)	LCRC Lib 5, Pg 190 (12/84)
Dec, 1831 original gov't corner set by Sylvester Sibley	Found 1" Pipe	Set C.I.M.
Set 1/4 Sec. post	NW TP 48.95'	5" Cherry NW 79.53'
7" Elm N48°W 39 links	SW TP 56.03'	Guard post ENE 70.17'
22" B. Ash S41°E 45 links	NE PP 89.50'	Sign post South 18.27'
		Power pole SE 108.89'

B. Description of corner evidence found and/or method applied in restoring or reestablishing corner:

H-11 Found 4" diameter cast iron monument in monument box
Monument is on ϕ Adam Street and 2' East of ϕ 20th Avenue to North
Found PK in S sde P. Pole S72°E 108.85'
 ϕ guard post (leaning) N80°E 70.6'

Accepted as a careful perpetuation of the position of the original corner.


P.A. 345 OTTAWA COUNTY

PEER APPROVED 10/23/95

Rodney D. Unema

C. Description of monument for corner and accessories established to perpetuate locating the position of the corner:

H-11 1/4 corner common to Sections 27 and 34
4" diameter cast iron monument in monument box
Monument is on ϕ Adams Street and 2' East of ϕ 20th Avenue to North
"X" on top of N end 12" conc culvert N73°E 72.59'
Set nail & OC tag in S sde P. Pole S72°E 108.86'
Set nail & OC tag in E sde 20" Maple S10°W 68.29'
Set nail & OC tag in N sde P. Pole S83°W 157.50'

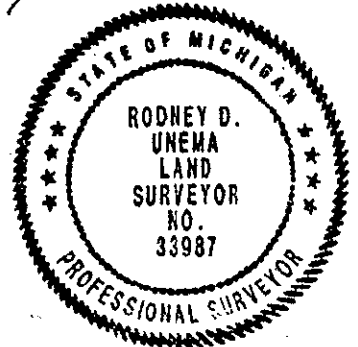

Signed by Rodney D. Unema
Surveyor's Michigan License No. 33987

Date October 20, 1995