

**Ottawa County Remonumentation
LAND CORNER RECORDATION CERTIFICATE
Filing Requirement of Act 74, Mich. P.A. 1970**

RECORDED

97 JUL 24 PM 2: 24

For corners in

Ottawa
(County)

Located In:

Corner Code #

- | | | |
|------------------------------------|--------------------------|---|
| 1. Public Land Survey | T <u>5N</u> R <u>13W</u> | <u>H-13 (S$\frac{1}{2}$, 34)</u> |
| | T _____ R _____ | <u>Jamestown Twp.</u> |
| | T _____ R _____ | _____ |
| | T _____ R _____ | _____ |
| 2. Property Controlling in Section | S _____ T _____ R _____ | _____ |
| | S _____ T _____ R _____ | _____ |
| 3. Miscellaneous Property in Sec. | S _____ T _____ R _____ | _____ |
| | S _____ T _____ R _____ | _____ |

Elizabeth Redman
REGISTER OF DEEDS
OTTAWA COUNTY, MI

Register of Deeds Stamp & File Number

4. Lot No. _____, Recorded Plat _____
5. Private Claims _____

	A	B	C	D	E	F	G	H	I	J	K	L	M
2	6		5		4		3		2		1		
3													
4	7		8		9		10		11		12		
5													
6	18		17		16		15		14		13		
7													
8	19		20		21		22		23		24		
9													
10	30		29		28		27		26		25		
11													
12	31		32		33		34		35		36		
13													

I, John C. Bueche, in a field survey on April 15, 1997, do hereby certify that under requirements of P.A. 74, Michigan P.A. of 1970, the corner points mentioned in lines 1 and 2 above were in conformance with regulations and rules therefore as required in the current manual of survey instructions of the United States Department of the Interior, Bureau of Land Management or by a decree of a Court of Law and/or that the corner points mentioned in lines 3, 4 and 5 above were in conformance with the rules of the Michigan Board of Land Surveyors or by a Decree of a Court of Law; established, re-established, monumented, re-monumented, recovered, found as expressed below:

NOTE: Not more than 4 corners, all in the same town and range, may be recorded on this certificate.

A. Description of original monument and accessories and/or subsequent restoration:

H-13 GLO, 1831 Lucius Lyon, DS Set H.M.P. Sugar 8 N 38 E 41 Beech 14 N 56 W 40	L882, P658 Allegan Co. CP Co. Survey Aug., 1976 Shows distances No jog @ this cor. NW cor. 3, 4-13 GLO 63.36' (Meas. 83.48') NE cor. 3, 4-13 GLO 43.56'
--	---

B. Description of corner evidence found and/or method applied in restoring or reestablishing corner:

H-13 Found angle iron on tree line North & C/L gravel road E-W
Meas. West to SW 34 2659.56' (CP Co. 2660.34' comp.)
Meas. East to SE 34 2639.42' (CP Co. 2639.36' comp.)

And is accepted as a careful and faithful perpetuation of the position of the original corner.

P.A. 345 OTTAWA COUNTY
PEER APPROVED 4/21/97


J.C.B.

C. Description of monument for corner and accessories established to perpetuate locating the position of the corner:

H-13 Replaced angle iron with Ottawa Co. Mon. (3/4" x 24" Pin with Alum. Cap)
Nail & CP Tag in SW side PP S 60° E 76.52'
Nail & Ottawa Co. Remon. Tag in SE side PP N 30° E 27.84'
Nail & Ottawa Co. Remon. Tag in S side 32" Osage Orange N 3° E 21.69'
Allegan Co. Mon. N 1/4 3, 4-13 East 53.03'
On C/L gravel road E-W; on tree row North

Signed by John C. Bueche
John C. Bueche, P.S. 13027
Surveyor's Michigan License No. _____

Date 5-29-97

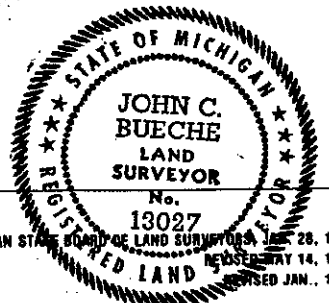

FORM APPROVED BY MICHIGAN STATE BOARD OF LAND SURVEYORS JAN 28, 1971
REVISED MAY 14, 1975
RENEWED JAN., 1983

\$ 9.00 CORNER