

SURVEY & REMONUMENTATION

NOV 10 1993

COMMISSION

**OTTAWA COUNTY REMONUMENTATION
LAND CORNER RECORDATION CERTIFICATE
Filing Requirement of Act 74, Mich. P.A. 1970**

For corners in

<u>Ottawa</u> (County)	Located In:	Corner Code #
	Jamestown Twp.	
1. Public Land Survey	T <u>5N</u> R <u>13W</u>	I-4 W 1/4 cor.
	T _____ R _____	Section <u>11</u>
	T _____ R _____	
	T _____ R _____	
2. Property Controlling in Section	S _____ T _____ R _____	
	S _____ T _____ R _____	
3. Miscellaneous Property in Sec.	S _____ T _____ R _____	
	S _____ T _____ R _____	
4. Lot No. _____, Recorded Plat _____		
5. Private Claims _____		

RECORDED
1993 SEP 29 PM 3:14

Phyllis Kallman
REGISTER OF DEEDS
OTTAWA COUNTY, MI

Register of Deeds Stamp & File Number

I, Rodney D. Unema, in a field survey on July 28/ 19 93, do hereby certify that under requirements of P.A. 74, Michigan P.A. of 1970, the corner points mentioned in lines 1 and 2 above were in conformance with regulations and rules therefore as required in the current manual of survey instructions of the United States Department of the Interior, Bureau of Land Management or by a decree of a Court of Law and/or that the corner points mentioned in lines 3, 4 and 5 above were in conformance with the rules of the Michigan Board of Land Surveyors or by a Decree of a Court of Law; established, re-established, monumented, re-monumented, recovered, found as expressed below:

	A	B	C	D	E	F	G	H	I	J	K	L	M
2	6	5	4	3	2	1							
3													
4	7	8	9	10	11	12							
5													
6	18	17	16	15	14	13							
7													
8	19	20	21	22	23	24							
9													
10	30	29	28	27	26	25							
11													
12	31	32	33	34	35	36							
13													


NOTE: Not more than 4 corners, all in the same town and range, may be recorded on this certificate.

A. Description of original monument and accessories and/or subsequent restoration:

I-4 1/4 Corner Between Sections 10 and 11
L.C.R.C. Liber 1, Page 305 (1972)
Found iron
Nail in side of P.Pole NW 74.65'
Nail in side of P.Pole SW 64.83'
Face of 40" Maple S-SE 95.66'
Face of 24" Maple S-SW 77.50'

B. Description of corner evidence found and/or method applied in restoring or reestablishing corner:

I-4 Found 1/2" rebar in Mon. Box at intersection of 16th Avenue and Greenly
Found PK nail in SE side P.Pole S44°W 64.88'
Found PK nail in SW side P.Pole N58°W 74.69'
Face of 40" Maple S11°E 95.6'

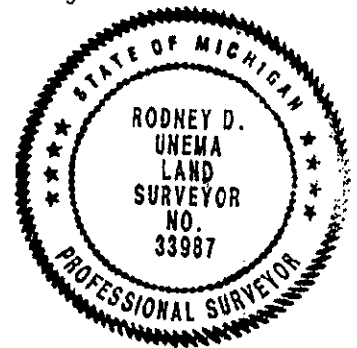

C. Description of monument for corner and accessories established to perpetuate locating the position of the corner:

I-4 1/4 Corner Between Sections 10 and 11
Replaced 1/2" rebar with Std. O.C. cap on 24" iron in Mon. Box. Encased in concrete flush with pavement. Accepted as a careful perpetuation of the position of the original corner.
C/L of 16th Avenue (B.T.) West 1.6'
C/L of Greenly Street (B.T.) South 1.2'
Nail & O.C. remon tag in W side 40" Maple S11°E 96.60'
Nail & O.C. remon tag in NW side P.Pole S44°W 65.00'
Nail & O.C. remon tag in SW side Ser. Pole N58°W 74.60'
Nail & O.C. remon tag in W side 14" Walnut N E 74.82'

Signed by Rodney D. Unema Date September 20, 1993
Surveyor's Michigan License No. 33987