

**SURVEY &  
REMONUMENTATION**

NOV 10 1993

**COMMISSION**

OTTAWA COUNTY REMONUMENTATION

**LAND CORNER RECORDATION CERTIFICATE**  
Filing Requirement of Act 74, Mich. P.A. 1970

For corners in  
Ottawa  
(County)

Located In:  
Jamestown Twp.

Corner Code #

1. Public Land Survey	T <u>5N</u> R <u>13W</u>	<u>I-5 SW cor.</u>
	T _____ R _____	<u>Section 11</u>
	T _____ R _____	_____
	T _____ R _____	_____
2. Property Controlling in Section	S _____ T _____ R _____	_____
	S _____ T _____ R _____	_____
3. Miscellaneous Property in Sec.	S _____ T _____ R _____	_____
	S _____ T _____ R _____	_____

**RECORDED**  
1993 SEP 29 PM 3:14

*Rodney D. Unema*  
REGISTER OF DEEDS  
OTTAWA COUNTY, MI

Register of Deeds Stamp & File Number

4. Lot No. \_\_\_\_\_, Recorded Plat \_\_\_\_\_  
5. Private Claims \_\_\_\_\_

A	B	C	D	E	F	G	H	I	J	K	L	M
2	6	5	4	3	2	1						
3												
4	7	8	9	10	11	12						
5												
6	18	17	16	15	14	13						
7												
8	19	20	21	22	23	24						
9												
10	30	29	28	27	26	25						
11												
12	31	32	33	34	35	36						
13												

I, Rodney D. Unema, in a field survey on July 28, 1993, do hereby certify that under requirements of P.A. 74, Michigan P.A. of 1970, the corner points mentioned in lines 1 and 2 above were in conformance with regulations and rules therefore as required in the current manual of survey instructions of the United States Department of the Interior, Bureau of Land Management or by a decree of a Court of Law and/or that the corner points mentioned in lines 3, 4 and 5 above were in conformance with the rules of the Michigan Board of Land Surveyors or by a Decree of a Court of Law; established, re-established, monumented, re-monumented, recovered, found as expressed below:

**NOTE: Not more than 4 corners, all in the same town and range, may be recorded on this certificate.**

A. Description of original monument and accessories and/or subsequent restoration:


I-5 L.C.R.C. Liber 1, Page 307 (1972)	L.C.R.C. Liber 5, Page 73 (1983)
1" I.P. in Mon. Box	Set cast iron monument
Nail in side of T.Pole NE 80.52'	Fence post SE 48.17'
Nail in side of T.Pole NW 75.38'	Sign post S-SW 66.88'
Nail in side of P.Pole SE 50.77'	P.Pole SE 50.78'
	Tele. ped. NW 76.48'

B. Description of corner evidence found and/or method applied in restoring or reestablishing corner:

I-5 Found O.C. Mon. in Mon. Box 5" below B.T. road surface  
Found PK nail in NW side fe. post SW 48.19'  
Found nail in NE side P.Pole S36°E 50.65'  
Found "X" in N end conc. culvert N57°E 43.59'  
Center of telephone pedestal NW 76.45'

C. Description of monument for corner and accessories established to perpetuate locating the position of the corner:

I-5 Placed Std. O.C. cap & bar over existing Harrison Mon., encased in concrete flush with pavement.  
At intersection of Riley Street and 16th Avenue  
C/L B.T. of Riley Street North 2.0'  
Set nail & O.C. tag in NE side of P.Pole S36°E 50.65'  
Set nail & O.C. tag in S side of Guy Pole N81°W 201.98'  
Chiseled "X" in S end of conc. culvert S60°W 38.23'  
Chiseled "X" in N end of conc. culvert N57°E 43.59'

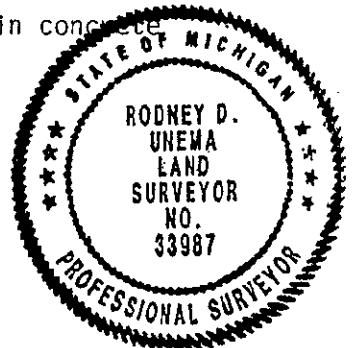

Signed by Rodney D. Unema Date September 20, 1993  
Surveyor's Michigan License No. 33987