

**SURVEY &
REMONUMENTATION**

APR 05 1996

COMMISSION

OTTAWA COUNTY REMONUMENTATION
LAND CORNER RECORDATION CERTIFICATE
Filing Requirement of Act 74, Mich. P.A. 1970

For corners in

OTTAWA
(County)

Located In: Jamestown Township
Corner Code ≠#

1. Public Land Survey	T	<u>5N</u>	R	<u>13W</u>	<u>I-7</u>
	T		R		
	T		R		
	T		R		
2. Property Controlling in Section	S		T	R	
	S		T	R	
3. Miscellaneous Property in Sec.	S		T	R	
	S		T	R	

RECORDED

95 NOV 15 PM 2:14

Rodney D. Unema
REGISTER OF DEEDS
OTTAWA COUNTY, MI

Register of Deeds Stamp & File Number

4. Lot No. _____, Recorded Plat _____
5. Private Claims _____

A	B	C	D	E	F	G	H	I	J	K	L	M
2	6	5	4	3	2	1						
3												
4	7	8	9	10	11	12						
5												
6	18	17	16	15	14	13						
7												
8	19	20	21	22	23	24						
9												
10	30	29	28	27	26	25						
11												
12	31	32	33	34	35	36						
13												

I, Rodney D. Unema, in a field survey on October 12, 1995, do hereby certify that under requirements of P.A. 74, Michigan P.A. of 1970, the corner points mentioned in lines 1 and 2 above were in conformance with regulations and rules therefore as required in the current manual of survey instructions of the United States Department of the Interior, Bureau of Land Management or by a decree of a Court of Law and/or that the corner points mentioned in lines 3, 4 and 5 above were in conformance with the rules of the Michigan Board of Land Surveyors or by a Decree of a Court of Law; established, re-established, monumented, re-monumented, recovered, found as expressed below:

NOTE: Not more than 4 corners, all in the same town and range, may be recorded on this certificate.

A. Description of original monument and accessories and/or subsequent restoration:

I-7 Corner common to Sections 14, 15, 22 and 23	LCRC Liber 2, Page 553	LCRC Liber 6, Page 170 (Sept., 1991)
Dec., 1831, original government corner set by Sylvester Sibley	(Sept., 1974)	
Set post	Set solid iron	Set Cast Iron Monument
14" Sugar N52°W 15 links	Nail on NE'ly sde P. Pole	T. Pole SW 40.12'
15" Elm S70°E 25 links	SE 44.69'	Power pole PK nail SE 44.69'
	Nail on W'ly sde P. Pole	Power pole PK nail NE 41.00'
	SW 40.27'	1/2" iron NW 40.36'
	Nail on NE'ly sde P. Pole	
	NW 56.59'	

B. Description of corner evidence found and/or method applied in restoring or reestablishing corner:

I-7 Found 3" diameter C.I.M. in Mon. Box at intersection of Byron Road and 16th Avenue	
Found PK nail in NE sde P. Pole	S48°E 44.67'
Found PK nail in E'ly sde P. Pole	S35°W 40.19'
Found PK nail in S'ly sde P. Pole	N52°E 40.92'

Accepted as a careful perpetuation of the position of the original corner.


P.A. 345 OTTAWA COUNTY

PEER APPROVED 10/23/95

Rodney D. Unema

C. Description of monument for corner and accessories established to perpetuate locating the position of the corner:

I-7 Corner common to Sections 14, 15, 22 and 23	
3" diameter C.I.M. in Mon. Box at intersection of Byron Road and 16th Avenue	
Set nail & OC tag in NE sde P. Pole	S48°E 44.67'
Set nail & OC tag in E'ly sde P. Pole	S35°W 40.19'
Set nail & OC tag in N'ly sde P. Pole	N52°E 41.27'
Set nail & OC tag in S'ly sde P. Pole	N76°W 223.46'

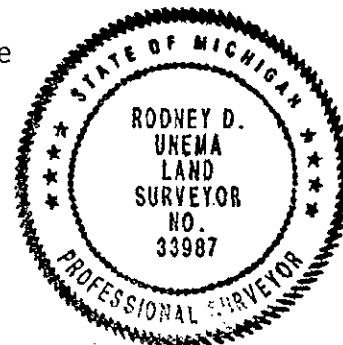

Signed by Rodney D. Unema
Surveyor's Michigan License No. 33987

Date October 20, 1995