

**SURVEY &
REMONUMENTATION**

APR 05 1996

OTTAWA COUNTY REMONUMENTATION
LAND CORNER RECORDATION CERTIFICATE
Filing Requirement of Act 74, Mich. P.A. 1970

COMMISSION

For corners in

OTTAWA

(County)

Located In:
Jamestown Township

Corner Code #

- | | | | | | |
|------------------------------------|---|----|---|-----|-----|
| 1. Public Land Survey | T | 5N | R | 13W | I-8 |
| | T | | R | | |
| | T | | R | | |
| | T | | R | | |
| 2. Property Controlling in Section | S | | T | R | |
| | S | | T | R | |
| 3. Miscellaneous Property in Sec. | S | | T | R | |
| | S | | T | R | |

RECORDED

95 NOV 15 PM 2:10

Rodney D. Unema
REGISTER OF DEEDS
OTTAWA COUNTY, MI

Register of Deeds Stamp & File Number

4. Lot No. _____, Recorded Plat _____
5. Private Claims _____

I, Rodney D. Unema, in a field survey on October 12, 19 95, do hereby certify that under requirements of P.A. 74, Michigan P.A. of 1970, the corner points mentioned in lines 1 and 2 above were in conformance with regulations and rules therefore as required in the current manual of survey instructions of the United States Department of the Interior, Bureau of Land Management or by a decree of a Court of Law and/or that the corner points mentioned in lines 3, 4 and 5 above were in conformance with the rules of the Michigan Board of Land Surveyors or by a Decree of a Court of Law; established, re-established, monumented, re-monumented, recovered, found as expressed below:

NOTE: Not more than 4 corners, all in the same town and range, may be recorded on this certificate.

	A	B	C	D	E	F	G	H	I	J	K	L	M
2	6	5	4	3	2	1							
3													
4	7	8	9	10	11	12							
5													
6	16	17	18	15	14	13							
7													
8	19	20	21	22	23	24							
9													
10	30	29	28	27	26	25							
11													
12	31	32	33	34	35	36							
13													

A. Description of original monument and accessories and/or subsequent restoration:

I-8 1/4 corner between Sections 22 and 23	LCRC Lib 3, Pg 165 (5/77)	LCRC Lib 3, Pg 314 (1/79)
Dec 1831 original gov't corner set by Sylvester Sibley	Found 3/4" iron	Steel bar over iron pipe
Set H.W.P.	PK in sde P. Pole SE 144.82'	24" Maple WNW 24.27'
14" Beech S30°E 25 links	Nail in sde 8" Elm NNW 62.13'	8" Elm NNW 62.15'
20" Beech S73°W 8 links	Nail in 22" Maple W 37.42'	Iron fence post West 24.5'
	On tree line to E & W	

B. Description of corner evidence found and/or method applied in restoring or reestablishing corner:

I-8 Found steel bar (10" below gravel) in iron pipe 2.0' East of & 16th Avenue	
Found nail in E sde 16" Elm	N18°W 62.14'
Found PK in E sde P. Pole	S17°E 144.79'
Iron fence post	N88°W 24.5'

Accepted steel bar as a careful perpetuation of the position of the original corner and replaced with standard Ottawa County Remon cap on 3/4" x 24" bar.


P.A. 345 OTTAWA COUNTY

PEER APPROVED 10/23/95

Rodney D. Unema

C. Description of monument for corner and accessories established to perpetuate locating the position of the corner:

I-8 1/4 corner between Sections 22 and 23	
Standard OC remon cap and 3/4" x 24" bar (8" below gravel)	
& 16th Avenue (gravel)	West 2.0'
Set nail & OC tag in E sde 16" Elm	N18°W 61.89'
Set nail & OC tag in W sde twin 14" Basswood	N17°E 71.95'
Set nail & OC tag in E sde P. Pole	S17°E 144.79'
Set nail & OC tag in N sde 24" Maple	N75°W 25.04'

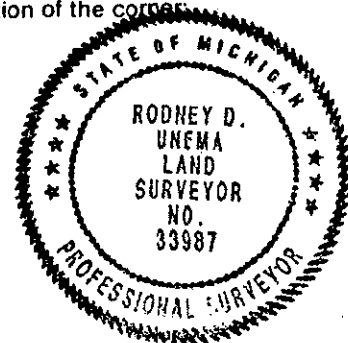

Signed by Rodney D. Unema

Date October 20, 1995

Surveyor's Michigan License No. 33987