

**Ottawa County Remonumentation  
LAND CORNER RECORDATION CERTIFICATE  
Filing Requirement of Act 74, Mich. P.A. 1970**

RECORDED

97 JUL 24 PM 2: 26

*Phyllis Robinson*  
REGISTER OF DEEDS  
OTTAWA COUNTY, MI

For corners in

<u>Ottawa</u> (County)	Located In:	Corner Code #
1. Public Land Survey	T <u>5N</u> R <u>13W</u>	<u>I-13 (SE, 34)</u>
	T _____ R _____	<u>Jamestown Twp.</u>
	T _____ R _____	_____
	T _____ R _____	_____
2. Property Controlling in Section	S _____ T _____ R _____	_____
	S _____ T _____ R _____	_____
3. Miscellaneous Property in Sec.	S _____ T _____ R _____	_____
	S _____ T _____ R _____	_____
4. Lot No. _____, Recorded Plat _____		
5. Private Claims _____		

Register of Deeds Stamp & File Number

I, John C. Bueche, in a field survey on April 15, 19 97, do hereby certify that under requirements of P.A. 74, Michigan P.A. of 1970, the corner points mentioned in lines 1 and 2 above were in conformance with regulations and rules therefore as required in the current manual of survey instructions of the United States Department of the Interior, Bureau of Land Management or by a decree of a Court of Law and/or that the corner points mentioned in lines 3, 4 and 5 above were in conformance with the rules of the Michigan Board of Land Surveyors or by a Decree of a Court of Law; established, re-established, monumented, re-monumented, recovered, found as expressed below:

	A	B	C	D	E	F	G	H	I	J	K	L	M
2	6	5	4	3	2	1							
3													
4	7	8	9	10	11	12							
5													
6	18	17	16	15	14	13							
7													
8	19	20	21	22	23	24							
9													
10	30	29	28	27	26	25							
11													
12	31	32	33	34	35	36							
13													

**NOTE: Not more than 4 corners, all in the same town and range, may be recorded on this certificate.**

A. Description of original monument and accessories and/or subsequent restoration:

I-13 GLO, 1831	L882, P658
Lucius Lyon, DS	CP Co. Survey, Aug., 1976
Set post corner	Shows dist.
Secs. 34 & 35	
Beech 4 N 17 E 20	
Beech 5 N 44 W 45	

B. Description of corner evidence found and/or method applied in restoring or reestablishing corner:

I-13 Found Ottawa Co. Mon. (Alum. Cap)  
On C/L gravel road North  
C/L gravel road E-W, North 2'±  
Meas. West to S 1/4 34 2639.42' (CP 2639.36')  
Meas. East to S 1/4 35 2639.86' (CP 2638.67')


And is accepted as a careful and faithful perpetuation of the position of the original corner.

P.A. 345 OTTAWA COUNTY  
PEER APPROVED 4/21/97

*S.D.N.*

C. Description of monument for corner and accessories established to perpetuate locating the position of the corner:

I-13 Ottawa Co. Mon. (Alum. Cap)  
Nail & Ottawa Co. Remon. Tag in W side PP N 18° E 71.82'  
Nail & Ottawa Co. Remon. Tag in S side PP N 60° W 144.49'  
Nail & Ottawa Co. Remon. Tag in N side 18" Elm S 70° E 46.04'  
Nail & Ottawa Co. Remon. Tag in S side PP N 70° E 171.77'  
On C/L gravel road North  
C/L gravel road E-W, North 2'±  
Allegan Co. Mon. NE 3, 4-13 East 43.63'

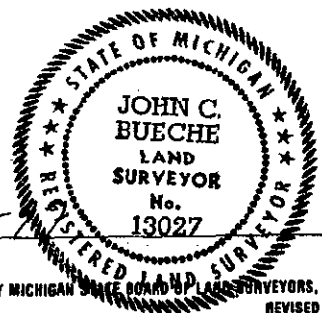

Signed by John C. Bueche  
John C. Bueche, P.S.  
Surveyor's Michigan License No. 13027

Date 5-29-97