

DEC 01 1993

OTTAWA COUNTY REMONUMENTATION

LAND CORNER RECORDATION CERTIFICATE
Filing Requirement of Act 74, Mich. P.A. 1970

RECORDED

93 NOV 11 AM 11:56

For copy to COMMISSIONER
Ottawa
(County)


Located In: Jamestown Township Corner Code # J-5

D. J. ...
REGISTER OF DEEDS
OTTAWA COUNTY, MI

- 1. Public Land Survey T 5N R 13W J-5
- T _____ R _____
- T _____ R _____
- T _____ R _____
- 2. Property Controlling S _____ T _____ R _____
- in Section S _____ T _____ R _____
- 3. Miscellaneous S _____ T _____ R _____
- Property in Sec. S _____ T _____ R _____

Register of Deeds Stamp & File Number

- 4. Lot No. _____ Recorded Plat _____
- 5. Private Claims _____

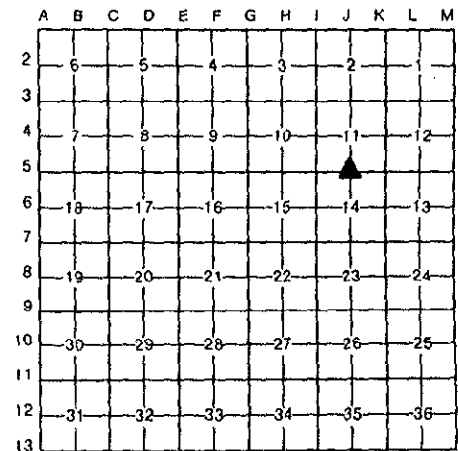

I, Rodney D. Unema, in a field survey on October 22, 1993, do hereby certify that under requirements of P.A. 74, Michigan P.A. of 1970, the corner points mentioned in lines 1 and 2 above were in conformance with regulations and rules therefore as required in the current manual of survey instructions of the United States Department of the Interior, Bureau of Land Management or by a decree of a Court of Law and/or that the corner points mentioned in lines 3, 4 and 5 above were in conformance with the rules of the Michigan Board of Land Surveyors or by a Decree of a Court of Law; established, re-established, monumented, re-monumented, recovered, found as expressed below:

NOTE: Not more than 4 corners, all in the same town and range, may be recorded on this certificate.

A. Description of original monument and accessories and/or subsequent restoration:

J-5 1/4 corner between Sections 11 and 14

L.C.R.C. Liber 5, Page 73 (Dec. 1983)

Cast Iron Mon.

Cor. fence post S 32.98'

Fence post SE 63.91'

13" Maple SW 40.37'

36" Maple WSW 79.28'

L.C.R.C. Liber 1, Page 307 (April 1972)

1" Solid Iron

Nail in sde of 14" Maple SSW 31.60'

Nail in sde of 26" Maple WSW 80.79'

NE corner of garage SW 83.86'

Mon. Box is on C/L of pavement and on line with fences N & S

B. Description of corner evidence found and/or method applied in restoring or reestablishing corner:

J-5 Found O.C. Cast Iron Mon. in Mon. Box (top broken off)

On C/L of E-W B.T. Road (Riley)

Found PK nail in top of fence post S5°W 33.47'

Found PK nail in top of fence post S55°E 63.74'

Accepted top of broken Mon. as a careful perpetuation of the position of the original corner.

Description of monument for corner and accessories established to perpetuate locating the position of the corner:

J-5 1/4 corner between Sections 11 and 14

Cast Iron Mon. in Mon. Box - top broken off

On C/L of E-W B.T. road (Riley)

Tree row to North

NW cor. block fndn. of house #1254

O.C. tag & nail in W sde P.Pole

"X" on E end of conc. culvert


"X" on W end of conc. culvert (6" East of broken end)

S53°W 129.04'

S 3°W 62.04'

N 3°W 24.68'

N45°W 34.36'

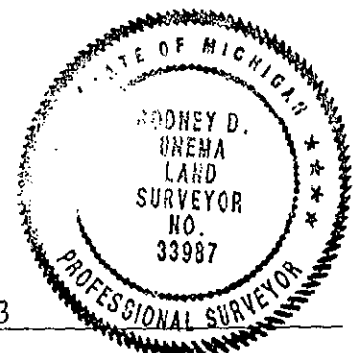

Red by

Rodney D. Unema

Date November 3, 1993

Surveyor's Michigan License No. 33987