

SURVEY & REMONUMENTATION

APR 05 1996

**OTTAWA COUNTY REMONUMENTATION
LAND CORNER RECORDATION CERTIFICATE
Filing Requirement of Act 74, Mich. P.A. 1970**

COMMISSION

For corners in

Ottawa
(County)

Located In:
Jamestown Township

Corner Code #

- | | | | | | |
|------------------------------------|---|----|---|-----|------|
| 1. Public Land Survey | T | 5N | R | 13W | J-11 |
| | T | | R | | |
| | T | | R | | |
| | T | | R | | |
| 2. Property Controlling in Section | S | | T | R | |
| | S | | T | R | |
| 3. Miscellaneous Property in Sec. | S | | T | R | |
| | S | | T | R | |
4. Lot No. _____, Recorded Plat _____
5. Private Claims _____

RECORDED

95 NOV 29 PM 1:42

Rodney D. Unema
REGISTER OF DEEDS
OTTAWA COUNTY, MI

Register of Deeds Stamp & File Number

I, Rodney D. Unema, in a field survey on October 13, 19 95, do hereby certify that under requirements of P.A. 74, Michigan P.A. of 1970, the corner points mentioned in lines 1 and 2 above were in conformance with regulations and rules therefore as required in the current manual of survey instructions of the United States Department of the Interior, Bureau of Land Management or by a decree of a Court of Law and/or that the corner points mentioned in lines 3, 4 and 5 above were in conformance with the rules of the Michigan Board of Land Surveyors or by a Decree of a Court of Law; established, re-established, monumented, re-monumented, recovered, found as expressed below:

NOTE: Not more than 4 corners, all in the same town and range, may be recorded on this certificate.

	A	B	C	D	E	F	G	H	I	J	K	L	M
2	6		5		4		3		2		1		
3													
4	7		8		9		10		11		12		
5													
6	18		17		16		15		14		13		
7													
8	19		20		21		22		23		24		
9													
10	30		29		28		27		26		25		
11													
12	31		32		33		34		35		36		
13													

A. Description of original monument and accessories and/or subsequent restoration:

J-11 1/4 corner between Sections 26 and 35
Dec., 1831, original govt LCRC Lib. 3, Page 369 (7/79)
Corner set by Sylvester Sibley 1" round iron in mon. box
Set post PK on W sde P. Pole S 48.42'
8" Elm S11° 8 links Face P. Pole N 71.1'
5" Sugar N70°W 11 links PK on N sde Walnut WSW 112.1'

LCRC Lib. 5, Pg 188 (12/84).
Set cast iron monument
P. Pole N 71.60'
5" Pine NE 54.05'
40" Ash S 46.83'
26" Walnut SW 112.12'

B. Description of corner evidence found and/or method applied in restoring or reestablishing corner:

J-11 Found cast iron monument in monument box (top broken off)
Monument is on ϕ of Adams Street
Found PK in W side of P. Pole N05°E 71.58'
Found nail in S side 10" Pine N70°E 56.02'
 ϕ 42" Ash S05°W 57' to center
Found PK in W side P. Pole S10°W 48.42'
 ϕ 28" Walnut S80°W 112' to center


P.A. 345 OTTAWA COUNTY
PEER APPROVED 11/20/95

Rodney D. Unema
JDN

Accepted as a careful perpetuation of the position of the original corner.

C. Description of monument for corner and accessories established to perpetuate locating the position of the corner:

J-11 1/4 corner between Sections 26 and 35
Cast iron monument in monument box (top broken off)
Monument is on ϕ of Adams Street
Set nail and OC tag in W side 12" Pine N05°E 33.60'
Set nail and OC tag in S side 10" Pine N70°E 56.04'
Set nail and OC tag in W side P. Pole S10°W 48.42'
Set nail and OC tag in N side 28" Walnut S80°W 112.42'

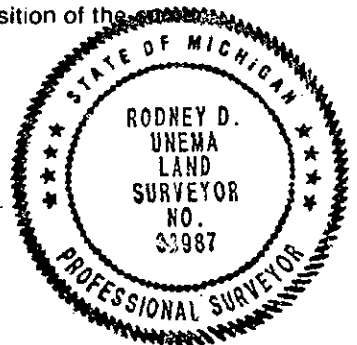

Signed by Rodney D. Unema

Date November 20, 1995

Surveyor's Michigan License No. 33987