

**SURVEY & REMONUMENTATION**

OTTAWA COUNTY REMONUMENTATION

FEB 27 1998

**LAND CORNER RECORDATION CERTIFICATE**  
Filing Requirement of Act 74, Mich. P.A. 1970

RECORDED

97 OCT 30 AM 10:59

For corners in  
Ottawa SECTION  
(County)

Located In:  
Jamestown Twp.

Corner Code #

1. Public Land Survey	T	5N	R	13W	K-2
	T		R		W 1/4, Sec. 1
	T		R		
	T		R		
2. Property Controlling in Section	S		T	R	
	S		T	R	
3. Miscellaneous Property in Sec.	S		T	R	
	S		T	R	

*Debra Grant*

Register of Deeds  
Ottawa County, Mi

Register of Deeds Stamp & File Number

4. Lot No. \_\_\_\_\_, Recorded Plat \_\_\_\_\_  
5. Private Claims \_\_\_\_\_

I, Rodney D. Unema, in a field survey on September 9, 19 97, do hereby certify that under requirements of P.A. 74, Michigan P.A. of 1970, the corner points mentioned in lines 1 and 2 above were in conformance with regulations and rules therefore as required in the current manual of survey instructions of the United States Department of the Interior, Bureau of Land Management or by a decree of a Court of Law and/or that the corner points mentioned in lines 3, 4 and 5 above were in conformance with the rules of the Michigan Board of Land Surveyors or by a Decree of a Court of Law; established, re-established, monumented, re-monumented, recovered, found as expressed below:

**NOTE: Not more than 4 corners, all in the same town and range, may be recorded on this certificate.**

A. Description of original monument and accessories and/or subsequent restoration:

K-2, 1/4 Cor. between Sections 1 & 2  
Oct. 1831, Orig. Gov't LCRC Lib. 1, Pg. 299 (4-7-72)  
Cor. set by Lucius Lyon Iron in Mon. box  
Set H.W.P. Nail in top of fence post SE 47.06'  
10" Lynn S66°E 19 links Center of St. sign post NW 34.34'  
9" Hickory N61°W 13 links Nail in side 32" Bass N-NW 59.0'  
Nail in side 8" Bass W-NW 46.3'

LCRC Lib. 2, Pg. 683 (10-22-74)  
Found iron pipe  
Nail in side 20" Boxelder SE 49.77'  
Nail in side 6" Boxelder N-NE 32.79'  
Nail in side 8" Willow NW 44.4  
Nail in side Power Pole SE 28.

\*(over)

B. Description of corner evidence found and/or method applied in restoring or reestablishing corner:

K-2  
Found C.I.M. @ Intersection of Ransom & 8th Ave.  
on centerline of Ransom to East  
Monument is 1.0 West of centerline B.T. of 8th Ave.  
Found scar in N. side 14" Ash N72°W 46.2'  
Street sign (leaning) N50°W 24.9'  
No other witnesses remaining


PA. 345 OTTAWA COUNTY  
PEER APPROVED 9-15-97

*[Signature]*

Accepted as a careful perpetuation of the position of the original corner.

C. Description of monument for corner and accessories established to perpetuate locating the position of the corner:

K-2 1/4 Corner between Sections 1 & 2  
4" Dia. Cast Iron Mon. - flush with pavement - Intersection of Ransom & 8th Ave.  
Set Nail & O.C. Tag in S side P. Pole S75°E 155.17'  
Set Nail & O.C. Tag in N side 14" Ash N72°W 46.18'  
Set Nail & O.C. Tag in W side 12" Elm N29°E 121.83'  
Property Corner (Tru-Line capped iron) S42°E 45.93'  
Centerline of N-S B.T. Road (8th Ave) West 1.0'  
On Centerline of B.T. Road to East (Ransom)

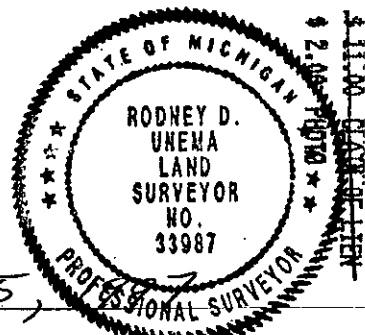

Signed by Rodney D. Unema  
Surveyor's Michigan License No. 33987

Date SEPT. 15, 1997

FORM APPROVED BY MICHIGAN STATE BOARD OF LAND SURVEYORS, JAN. 29, 1971  
REVISED MAY 14, 1975  
REVISED JAN., 1983

LCRC Lib 5, Pg. 348 (12-6-88)  
Found Iron Pipe, set C.I.M.  
Center St. sign NW 24.89'  
Nail in Fence Post SE 48.14'  
Nail in N Side PP S75°E 153.65'  
Nail in N Side 10" Ash N70°W 46.15'

**SURVEY &  
REMONUMENTATION**

**FEB 27 1998**

**SECTION**