

# SURVEY & REMONUMENTATION

APR 25 1995

OTTAWA COUNTY REMONUMENTATION  
LAND CORNER RECORDATION CERTIFICATE  
Filing Requirement of Act 74, Mich. P.A. 1970

RECORDED  
94 DEC -8 PM 12: 29

For corners in **COMMISSION**

Ottawa <small>(County)</small>	Located In: Jamestown Township	Corner Code #
1. Public Land Survey	T <u>5N</u> R <u>13W</u>	<u>K-11</u>
	T _____ R _____	_____
	T _____ R _____	_____
	T _____ R _____	_____
2. Property Controlling in Section	S _____ T _____ R _____	_____
	S _____ T _____ R _____	_____
3. Miscellaneous Property in Sec.	S _____ T _____ R _____	_____
	S _____ T _____ R _____	_____

*D. J. ...*  
REGISTER OF DEEDS  
OTTAWA COUNTY, MI

Register of Deeds Stamp & File Number

4. Lot No. \_\_\_\_\_, Recorded Plat \_\_\_\_\_  
5. Private Claims \_\_\_\_\_

I, Rodney D. Unema, in a field survey on Nov. 7, 19 94, do hereby certify that under requirements of P.A. 74, Michigan P.A. of 1970, the corner points mentioned in lines 1 and 2 above were in conformance with regulations and rules therefore as required in the current manual of survey instructions of the United States Department of the Interior, Bureau of Land Management or by a decree of a Court of Law and/or that the corner points mentioned in lines 3, 4 and 5 above were in conformance with the rules of the Michigan Board of Land Surveyors or by a Decree of a Court of Law; established, re-established, monumented, re-monumented, recovered, found as expressed below:

	A	B	C	D	E	F	G	H	I	J	K	L	M
2	6	5	4	3	2	1							
3													
4	7	8	9	10	11	12							
5													
6	18	17	16	15	14	13							
7													
8	19	20	21	22	23	24							
9													
10	30	29	28	27	26	25							
11													
12	31	32	33	34	35	36							
13													

**NOTE: Not more than 4 corners, all in the same town and range, may be recorded on this certificate.**

**A. Description of original monument and accessories and/or subsequent restoration:**

K-11 Corner common to Sections 25, 26, 35 and 36	L.C.R.C. Liber 5, Page 188
Original gov't corner set in L.C.R.C. Liber 1, Page 279	(Dec. 27, 1984)
Dec. 1831 by Sylvester Sibley (Feb. 15, 1972)	Set cast iron Mon.
Set post Found 3/4" pipe	P. Pole NE 72.14'
Beech 10" S33°W 22 links Nail in face of 18" Maple	30" Maple NW 114.30'
Beech 28" N56°E 42 links NW 68.10'	32" Maple SW 71.89'
Nail in face of 24" Oak SW 53.75'	10" Ash SE 72.32'
Nail in face of PP SE 67.86'	
Nail in face of PP NE 72.08'	

**B. Description of corner evidence found and/or method applied in restoring or reestablishing corner:**


K-11  
Found Cast Iron Mon. in Mon. Box (top broken off) at intersection of Adams and 8th Avenue  
Found PK in SE side of P.P. N71°E 72.70'  
Found nail & bottle cap in face of P.P. N71°E 72.12'  
Found nail in N side 36" Maple S70°W 71.91'

Accepted center of Cast Iron Mon. as a careful perpetuation of the position of the original corner.

**P.A. 345 OTTAWA COUNTY**  
**PEER APPROVED** 11/21/94  
*Rodney D. Unema*

**C. Description of monument for corner and accessories established to perpetuate locating the position of the corner:**

K-11 Corner common to Sections 25, 26, 35 and 36	
Cast Iron Mon. in Mon. Box (top broken off)	
Set nail & O.C. tag in SE side of P.P.	N71°E 72.59'
Set nail & O.C. tag in E side of 32" Maple	N13°W 114.62'
Set nail & O.C. tag in N side of 36" Maple	S70°W 71.89'
Set nail & O.C. tag in SW side of twin 10" Maple	S44°E 78.16'
at C/L "X" of Adams Street & 8th Avenue	

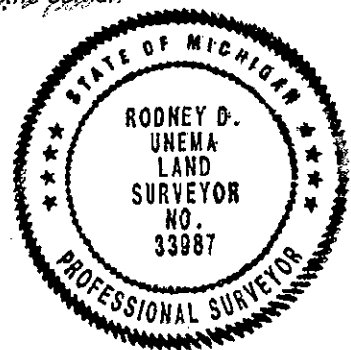

Signed by *Rodney D. Unema* Date Nov. 17, 1994  
Surveyor's Michigan License No. 33987