

**SURVEY &  
REMONUMENTATION**

DEC 01 1993

OTTAWA COUNTY REMONUMENTATION  
**LAND CORNER RECORDATION CERTIFICATE**  
Filing Requirement of Act 74, Mich. P.A. 1970

RECORDED  
93 NOV 11 AM 11:56

For corners in **COMMISSION**

Ottawa  
(County)

Located In: Corner Code #

Jamestown Township

- |                                    |                          |            |
|------------------------------------|--------------------------|------------|
| 1. Public Land Survey              | T <u>5N</u> R <u>13W</u> | <u>L-5</u> |
|                                    | T _____ R _____          | _____      |
|                                    | T _____ R _____          | _____      |
|                                    | T _____ R _____          | _____      |
| 2. Property Controlling in Section | S _____ T _____ R _____  | _____      |
|                                    | S _____ T _____ R _____  | _____      |
| 3. Miscellaneous Property in Sec.  | S _____ T _____ R _____  | _____      |
|                                    | S _____ T _____ R _____  | _____      |

*Stephen R. Robinson*  
REGISTER OF DEEDS  
OTTAWA COUNTY, MI

Register of Deeds Stamp & File Number

4. Lot No. \_\_\_\_\_, Recorded Plat \_\_\_\_\_  
5. Private Claims \_\_\_\_\_

I, Rodney D. Unema, in a field survey on October 22, 19 93, do hereby certify that under requirements of P.A. 74, Michigan P.A. of 1970, the corner points mentioned in lines 1 and 2 above were in conformance with regulations and rules therefore as required in the current manual of survey instructions of the United States Department of the Interior, Bureau of Land Management or by a decree of a Court of Law and/or that the corner points mentioned in lines 3, 4 and 5 above were in conformance with the rules of the Michigan Board of Land Surveyors or by a Decree of a Court of Law; established, re-established, monumented, re-monumented, recovered, found as expressed below:

A	B	C	D	E	F	G	H	I	J	K	L	P
2	6	5	4	3	2	1						
3												
4	7	8	9	10	11	12						
5												
6	18	17	16	15	14	13						
7												
8	19	20	21	22	23	24						
9												
10	30	29	28	27	26	25						
11												
12	31	32	33	34	35	36						
13												

**NOTE: Not more than 4 corners, all in the same town and range, may be recorded on this certificate.**

A. Description of original monument and accessories and/or subsequent restoration:


L-5 1/4 corner between Sections 12 and 13  
L.C.R.C. Liber 1, Page 327 (April 1972)  
3/4" iron  
NW cor. hse. fndn. SE 119.29'  
Nail in sde T.Pole SSW 87.70'  
Nail in sde 24" Maple ENE 88.37'  
Nail in sde 4" Maple WNW 60.31'  
C/L of gravel S 8'+

B. Description of corner evidence found and/or method applied in restoring or reestablishing corner:

L-5 Found capped re-rod in gravel road  
C/L E-W gravel road (Riley) South 8.0'  
NW cor. hse. fndn. S43°E 119.22'  
Found PK nail in E sde Service Pole S05°W 87.55'  
Found PK nail in E sde P.Pole S10°W 33.12'  
Accepted as a careful perpetuation of the position of the original corner.  
Replaced re-rod with Std. O.C. cap on 24" iron bar.

C. Description of monument for corner and accessories established to perpetuate locating the position of the corner:

L-5 1/4 corner between Sections 12 and 13  
Std. O.C. cap on 3/4" x 24" iron bar, 6" below surface of gravel road  
C/L of E-W gravel road (Riley) South 8'  
Brush/tree rows to N and S (old fence line to N.)  
O.C. tag & nail in E sde P.Pole S10°W 33.28'  
O.C. tag & nail in W sde Service Pole N07°E 61.31'  
SW cor. brick house #378 S33°E 143.26'  
O.C. tag & PK nail in top of conc. headwall S75°W 141.55'

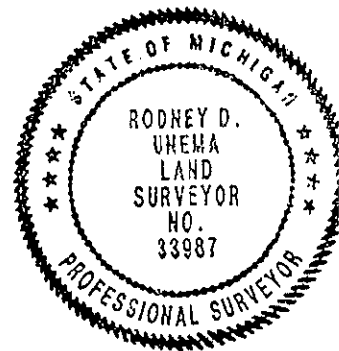

Signed by Rodney D. Unema Date November 4, 1993  
Surveyor's Michigan License No. 33987