

# SURVEY & REMONUMENTATION

APR 25 1995

OTTAWA COUNTY REMONUMENTATION  
**LAND CORNER RECORDATION CERTIFICATE**  
Filing Requirement of Act 74, Mich. P.A. 1970

RECORDED

94 DEC -8 PM 12: 29

For corners in **COMMISSION**

Ottawa <small>(County)</small>	Located In: Jamestown Township	Corner Code # L-7
1. Public Land Survey	T <u>5N</u> R <u>13W</u>	<u>L-7</u>
	T _____ R _____	_____
	T _____ R _____	_____
	T _____ R _____	_____
2. Property Controlling in Section	S _____ T _____ R _____	_____
	S _____ T _____ R _____	_____
3. Miscellaneous Property in Sec.	S _____ T _____ R _____	_____
	S _____ T _____ R _____	_____

*Rodney D. Unema*  
REGISTER OF DEEDS  
OTTAWA COUNTY, MI

Register of Deeds Stamp & File Number

1. Lot No. \_\_\_\_\_, Recorded Plat \_\_\_\_\_  
5. Private Claims \_\_\_\_\_

Rodney D. Unema, in a field survey on Nov. 7, 19 94,  
to hereby certify that under requirements of P.A. 74, Michigan P.A. of 1970, the corner points mentioned  
in lines 1 and 2 above were in conformance with regulations and rules therefore as required in the  
current manual of survey instructions of the United States Department of the Interior, Bureau of Land  
Management or by a decree of a Court of Law and/or that the corner points mentioned in lines 3, 4 and 5  
above were in conformance with the rules of the Michigan Board of Land Surveyors or by a Decree of a  
Court of Law; established, re-established, monumented, re-monumented, recovered, found as  
expressed below:

	A	B	C	D	E	F	G	H	I	J	K	L	M
2	6	5	4	3	2	1							
3													
4	7	8	9	10	11	12							
5													
6	18	17	16	15	14	13							
7													
8	19	20	21	22	23	24							
9													
10	30	29	28	27	26	25							
11													
12	31	32	33	34	35	36							
13													

**NOTE: Not more than 4 corners, all in the same town and range, may be recorded on this certificate.**

1. Description of original monument and accessories and/or subsequent restoration:

L-7 1/4 Corner between Sections 13 and 24 Original gov't corner set in Dec. 1831 by Sylvester Sibley Set post Beech 12" S8°E 14 links Beech 8" N1°W 24 links	L.C.R.C. Liber 2, Page 389 (Nov. 26, 1973) Set 3/4" iron at midpoint on line NW corner gar. SSE 85.36' Nail in side T.Pole ESE 124.21' Iron on tree & fence line to South
---	---

3. Description of corner evidence found and/or method applied in restoring or reestablishing corner:


L-7 Found 3/4" iron in Mon. Box C/L of E-W B.T. road (Byron Road) Found nail & bottle cap in S'ly side T.Pole NW corner garage (house #392) alum. siding	South 1.0' S70°E 124.19' S15°E 85.55'
--	---

Accepted as a careful perpetuation of the position of the original corner,  
and replaced 3/4" iron pipe with Std. O.C. Cap on 24" x 3/4" iron bar in Mon. Box.

**P.A. 345 OTTAWA COUNTY**  
**PEER APPROVED** 11/21/94  
*Rodney D. Unema*

3. Description of monument for corner and accessories established to perpetuate locating the position of the corner:

L-7 1/4 Corner between Sections 13 and 24 Std. O.C. cap on 24" x 3/4" iron bar in Mon. Box C/L of E-W B.T. road Set nail & O.C. tag in W side 14" Maple Set nail & O.C. tag in SW side T.Pole Set nail & O.C. tag in S side P.Pole Set nail & O.C. tag in S side T.Pole Tree row to the South	South 1.0' S07°E 73.00' S70°E 124.19' N70°E 138.52' N70°W 165.88'
--	---

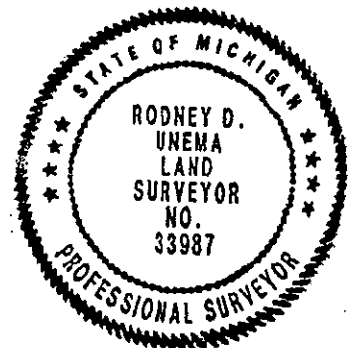

Signed by Rodney D. Unema Date Nov. 17, 1994

Surveyor's Michigan License No. 33987