

SURVEY & REMONUMENTATION

APR 25 1995

OTTAWA COUNTY REMONUMENTATION
LAND CORNER RECORDATION CERTIFICATE
Filing Requirement of Act 74, Mich. P.A. 1970

RECORDED

94 DEC -8 PM 12:29

For corners in **COMMISSION**

Ottawa <small>(County)</small>	Located In:	Corner Code #	
	Jamestown Township		
1. Public Land Survey	T 5N R 13W	L-11	
	T _____ R _____		
	T _____ R _____		
	T _____ R _____		
2. Property Controlling in Section	S _____ T _____ R _____		
	S _____ T _____ R _____		
3. Miscellaneous Property in Sec.	S _____ T _____ R _____		
	S _____ T _____ R _____		
4. Lot No. _____, Recorded Plat _____			
5. Private Claims _____			

Sylvester Sibley
REGISTER OF DEEDS
OTTAWA COUNTY, MI

Register of Deeds Stamp & File Number

I, Rodney D. Unema, in a field survey on Nov. 7, 19 94, do hereby certify that under requirements of P.A. 74, Michigan P.A. of 1970, the corner points mentioned in lines 1 and 2 above were in conformance with regulations and rules therefore as required in the current manual of survey instructions of the United States Department of the Interior, Bureau of Land Management or by a decree of a Court of Law and/or that the corner points mentioned in lines 3, 4 and 5 above were in conformance with the rules of the Michigan Board of Land Surveyors or by a Decree of a Court of Law; established, re-established, monumented, re-monumented, recovered, found as expressed below:

	A	B	C	D	E	F	G	H	I	J	K	L	M
2	6	5	4	3	2	1							
3													
4	7	8	9	10	11	12							
5													
6	18	17	16	15	14	13							
7													
8	19	20	21	22	23	24							
9													
10	30	29	28	27	26	25							
11													
12	31	32	33	34	35	36							
13													

NOTE: Not more than 4 corners, all in the same town and range, may be recorded on this certificate.

A. Description of original monument and accessories and/or subsequent restoration:

L-11 1/4 Corner between Sections 25 and 36
Original gov't corner set in L.C.R.C. Liber 1, Page 279
Dec. 1831 by Sylvester Sibley (Feb. 15, 1972)
Set 1/4 Section post Iron bar
Sugar 10" S39°W 35 links Nail in face of 12" Maple N 99.83'
Beech 18" N81°E 25 links Nail in face of PP N 122.68'
Nail in face of 30" Maple ESE 90.35'
Nail in face of Oak S 66.04'
Nail in face of 24" Maple ESE 121.90'

** see other si
L.C.R.C. Liber 3, Page 31
(July 2, 1979)
Iron in Mon. Box
PK in side P.Pole N 122.68'
Spk in side 36" Maple
South 66.82'
Spk in side 36" Maple
SE 92.27'

B. Description of corner evidence found and/or method applied in restoring or reestablishing corner:

L-11
Found Cast Iron Mon. in Mon. Box (top broken off)
on C/L of Adams Street (E-W B.T. road)
Found PK & tag in W side P.Pole N 00°E 122.69'
Found nail in 40" Maple (N side) S 72°E 92.25'
Found nail in 36" Maple (W side) S 00°E 66.9'
Found nail in 12" Maple S 02°E 49.29'

Mon. Box is on C/L B.T.


Accepted as a careful perpetuation of the position of the original corner.

P.A. 345 OTTAWA COUNTY

PEER APPROVED 11/21/94

C. Description of monument for corner and accessories established to perpetuate locating the position of the corner:

L-11 1/4 Corner Common to Sections 25 and 36
Cast Iron Mon. in Mon. Box (Center of Mon.)
on C/L of E-W B.T. Road (Adams Street)
Set nail & O.C. tag in W side of P.P. N00°E 122.69'
Set nail & O.C. tag in N side 40" Maple S72°E 92.25'
Set nail & O.C. tag in W side 12" Maple S02°E 49.29'
Set nail & O.C. tag in SW side P.P. N60°W 220.44'
Tree row to South

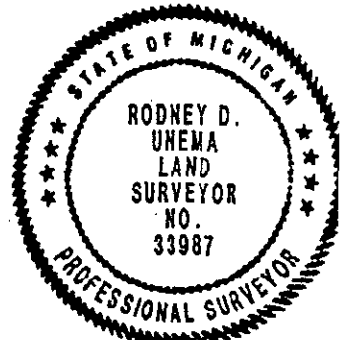

Signed by Rodney D. Unema

Date Nov. 17, 1994

Surveyor's Michigan License No. 33987

FORM APPROVED BY MICHIGAN STATE BOARD OF LAND SURVEYORS, JAN. 28, 1971
REVISED MAY 14, 1975
REVISED JAN., 1983

OTTAWA

L-11
L.C.R.C. Liber 5, Page 188 (Dec. 27, 1984)
Set Cast Iron Mon.
Power Pole N 122.71'
12" Maple S 49.25'
40" Maple SE 91.71'

1200
9.00
1.50
2.00