

SURVEY & REMONUMENTATION

DEC 01 1993

OTTAWA COUNTY REMONUMENTATION
LAND CORNER RECORDATION CERTIFICATE
 Filing Requirement of Act 74, Mich. P.A. 1970

RECORDED
 93 NOV 11 AM 11:56

Rodney D. Unema
 REGISTER OF DEEDS
 OTTAWA COUNTY, MI

COMMISSION
 For corners in

Ottawa (County)	Located In:	Corner Code #
	Jamestown Township	
1. Public Land Survey	T <u>5N</u> R <u>13W</u>	<u>M-3</u>
	T _____ R _____	_____
	T _____ R _____	_____
	T _____ R _____	_____
2. Property Controlling in Section	S _____ T _____ R _____	_____
	S _____ T _____ R _____	_____
3. Miscellaneous Property in Sec.	S _____ T _____ R _____	_____
	S _____ T _____ R _____	_____

Register of Deeds Stamp & File Number

4. Lot No. _____, Recorded Plat _____
 5. Private Claims _____

	A	B	C	D	E	F	G	H	I	J	K	L	M
2	6		5		4		3		2		1		
3													
4	7		8		9		10		11		12		
5													
6	18		17		16		15		14		13		
7													
8	19		20		21		22		23		24		
9													
10	30		29		28		27		26		25		
11													
12	31		32		33		34		35		36		
13													

I, Rodney D. Unema, in a field survey on October 22, 19 93, do hereby certify that under requirements of P.A. 74, Michigan P.A. of 1970, the corner points mentioned in lines 1 and 2 above were in conformance with regulations and rules therefore as required in the current manual of survey instructions of the United States Department of the Interior, Bureau of Land Management or by a decree of a Court of Law and/or that the corner points mentioned in lines 3, 4 and 5 above were in conformance with the rules of the Michigan Board of Land Surveyors or by a Decree of a Court of Law; established, re-established, monumented, re-monumented, recovered, found as expressed below:

NOTE: Not more than 4 corners, all in the same town and range, may be recorded on this certificate.

A. Description of original monument and accessories and/or subsequent restoration:


M-3 SE corner, Section 1 and NE corner, Section 12		
L.C.R.C. Liber 5, Pg. 352 (Dec. 1988)	L.C.R.C. Liber 5, Pg. 208 (May 1985)	L.C.R.C. Liber 3, Pg. 111 (Oct. 1976)
Cast Iron Mon.	1/2" iron	3/4" iron
PP SE 77.18'	KC Mon.	Nail in W sde 6" Maple SSW 114.1
12" Ash SW 91.27'	Spk in NE sde 16" tree	Nail in NW sde P.Pole SE 77.18
12" Elm NW 82.29'	Remon tag in SW sde P.Pole	PK in top wood guard post ENE 40.62
K.C. CIM N 28.0'	Spk in NW sde 8" Ash	PK in top wood guard post NE 64.55
		Iron N 28.07

B. Description of corner evidence found and/or method applied in restoring or reestablishing corner:

M-3 Found capped "Exxel" iron in BT and O.C. Cast iron Mon. below - 12" below pavement
 K.C. Mon. North 28.00'
 PK in NE sde P.Pole S33°E 77.53'
 Found spike in NW sde 14" Ash S67°W 91.29'
 Found nail in 12" Elm N68°W 82.26'
 Accepted as a careful perpetuation of the position of the original corner.
 Set new Mon. Box flush with pavement and placed Std. O.C. cap on 3/4" x 10" iron bar in Mon. Box on top of existing cast iron monument.

C. Description of monument for corner and accessories established to perpetuate locating the position of the corner:

M-3 Std. O.C. cap on 3/4" x 10" iron bar in Mon. Box
 On C/L of N-S BT road (Kenowa)
 On C/L of gravel road to West (Quincy)
 Kent Co. Mon. A-3 North 28.00'
 O.C. tag & nail in SW sde P.Pole S33°E 77.47'
 O.C. tag & nail in NW sde 14" Ash S67°W 91.16'
 O.C. tag & nail in NE sde 12" Elm N68°W 82.15'
 O.C. tag & nail in joint of head curb N75°E 40.64'

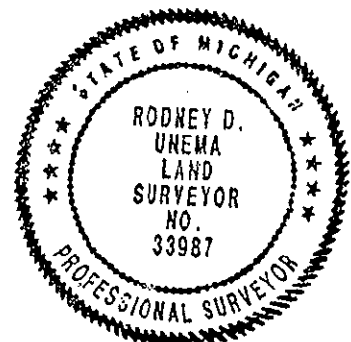

Signed by Rodney D. Unema Date November 4, 1993
 Surveyor's Michigan License No. 33987

FORM APPROVED BY MICHIGAN STATE BOARD OF LAND SURVEYORS, JAN. 28, 1971
 REVISED MAY 14, 1975
 REVISED JAN., 1983