

**SURVEY & REMONUMENTATION**

DEC 01 1993

OTTAWA COUNTY REMONUMENTATION

RECORDED

COMMISSION

LAND CORNER RECORDATION CERTIFICATE  
Filing Requirement of Act 74, Mich. P.A. 1970

93 NOV 11 AM 11:56

For corners in

Ottawa (County)	Located In:	Corner Code #
	Jamestown Township	
1. Public Land Survey	T 5N R 13W	M-4
	T ___ R ___	___
	T ___ R ___	___
	T ___ R ___	___
2. Property Controlling in Section	S ___ T ___ R ___	___
	S ___ T ___ R ___	___
3. Miscellaneous Property in Sec.	S ___ T ___ R ___	___
	S ___ T ___ R ___	___
4. Lot No. _____, Recorded Plat _____		
5. Private Claims _____		

*Rodney D. Unema*  
REGISTER OF DEEDS  
OTTAWA COUNTY, MI

Register of Deeds Stamp & File Number

I, Rodney D. Unema, in a field survey on October 1, 19 93, do hereby certify that under requirements of P.A. 74, Michigan P.A. of 1970, the corner points mentioned in lines 1 and 2 above were in conformance with regulations and rules therefore as required in the current manual of survey instructions of the United States Department of the Interior, Bureau of Land Management or by a decree of a Court of Law and/or that the corner points mentioned in lines 3, 4 and 5 above were in conformance with the rules of the Michigan Board of Land Surveyors or by a Decree of a Court of Law; established, re-established, monumented, re-monumented, recovered, found as expressed below:

	A	B	C	D	E	F	G	H	I	J	K	L	M
2	6	5	4	3	2	1							
3													
4	7	8	9	10	11	12							
5													
6	13	17	16	15	14	13							
7													
8	19	20	21	22	23	24							
9													
10	30	29	28	27	26	25							
11													
12	31	32	33	34	35	36							
13													

**NOTE: Not more than 4 corners, all in the same town and range, may be recorded on this certificate.**

A. Description of original monument and accessories and/or subsequent restoration:

M-4 E 1/4 corner of Section 12

L.C.R.C. Liber 6, Pg. 190  
(Nov. 1991)

L.C.R.C. Liber 5, Pg. 208  
(January 1985)

L.C.R.C. Liber 1, Pg. 327  
(April 1972)

Capped "Exxel" iron in BT road

K.C. remon

NW cor hse fndn #03575

Found lg. spk in S sde Tw 12" Elm

Found lg. spk in N sde tr. 12" Boxelder

C/L of BT

N 155.87'

SW 97.25'

E 61.32'

W 28.07'

W 3'

Spk N sde 8" tr. Maple West 28.15'  
Spk N sde 8" tw. Elm S80°E 61.28'  
Spk SW sde 6" Elm S40°E 31.72'  
Sg. spk N sde 16" Poplar S15°E 96.48'  
NE cor alu siding on hse S45°W 74.19'  
K.C. Mon. North 155.88'  
Iron is on C/L of N-S gravel road

SE cor hse fndn SW 92.21'  
Nail in sde 12" Apple WSW 52.9°  
Nail in sde 12" Poplar SSE 96.5°  
Nail in sde 4" Birch NE 43.2°  
On C/L gravel N & S

B. Description of corner evidence found and/or method applied in restoring or reestablishing corner:

M-4 Found capped "Exxel" iron in BT road

C/L BT N-S road (Kenowa Ave.) West 2.5'

K.C. Remon North 155.87'

Spk in S sde tw. Elm (dead) S80°E 61.32'

Spk in N sde tr. Ash N87°W 28.05'

NW cor. hse fndn. (#03575) S65°W 97.25'

Accepted as a careful perpetuation of the position of the original corner.

Replaced existing iron with Std. O.C. cap on 3/4" x 24" iron bar

C. Description of monument for corner and accessories established to perpetuate locating the position of the corner:

M-4 E 1/4 corner, Section 12

Std. O.C. cap on 3/4" x 24" iron bar flush with pavement, encased in conc.

C/L N-S BT road (Kenowa Ave.) West 2.5'


K.C. Remon (Harrison Mon.) North 155.87'

NW cor fndn. of house #03575 S65°W 97.25'

O.C. tag & nail in N sde triple 12" Ash N87°W 27.72'

O.C. tag & nail in NE sde 10" Wild Cherry S43°E 58.90'

O.C. tag & nail in W sde 20" Elm N29°E 59.70'

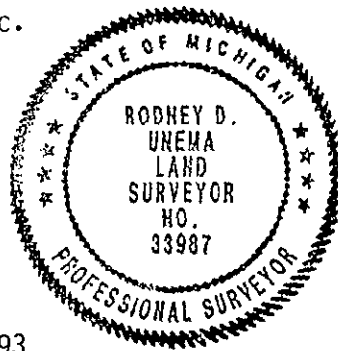

igned by Rodney D. Unema

Date November 4, 1993

urveyor's Michigan License No. 33987

FORM APPROVED BY MICHIGAN STATE BOARD OF LAND SURVEYORS, JAN. 28, 1971  
REVISED MAY 14, 1975  
REVISED JAN., 1983