

**SURVEY &  
REMONUMENTATION**

APR 25 1995

OTTAWA COUNTY REMONUMENTATION  
**LAND CORNER RECORDATION CERTIFICATE**  
Filing Requirement of Act 74, Mich. P.A. 1970

RECORDED

94 DEC -8 PM 12:29

For corners in **COMMISSION**

<u>Ottawa</u> (County)	Located In: Jamestown Township	Corner Code # M-7
1. Public Land Survey	T <u>5N</u> R <u>13W</u>	<u>M-7</u>
	T _____ R _____	_____
	T _____ R _____	_____
	T _____ R _____	_____
2. Property Controlling in Section	S _____ T _____ R _____	_____
	S _____ T _____ R _____	_____
3. Miscellaneous Property in Sec.	S _____ T _____ R _____	_____
	S _____ T _____ R _____	_____

*Robert L. Carlsson*  
REGISTER OF DEEDS  
OTTAWA COUNTY, MI

Register of Deeds Stamp & File Number

4. Lot No. \_\_\_\_\_, Recorded Plat \_\_\_\_\_  
5. Private Claims \_\_\_\_\_

I, Rodney D. Unema, in a field survey on Nov. 7, 19 94, do hereby certify that under requirements of P.A. 74, Michigan P.A. of 1970, the corner points mentioned in lines 1 and 2 above were in conformance with regulations and rules therefore as required in the current manual of survey instructions of the United States Department of the Interior, Bureau of Land Management or by a decree of a Court of Law and/or that the corner points mentioned in lines 3, 4 and 5 above were in conformance with the rules of the Michigan Board of Land Surveyors or by a Decree of a Court of Law; established, re-established, monumented, re-monumented, recovered, found as expressed below:

	A	B	C	D	E	F	G	H	I	J	K	L	M
2	6	5	4	3	2	1							
3													
4	7	8	9	10	11	12							
5													
6	18	17	16	15	14	13							
7													
8	19	20	21	22	23	24							
9													
10	30	29	28	27	26	25							
11													
12	31	32	33	34	35	36							
13													

**NOTE: Not more than 4 corners, all in the same town and range, may be recorded on this certificate.**

A. Description of original monument and accessories and/or subsequent restoration:

M-7 Corner Common to Sections 13 and 24  
Original gov't corner set on Oct. 18, 1831  
by Lucius Lyon  
Set post  
Butternut 20" S37°W 27 links  
Elm 8" N19°W 30 links

L.C.R.C. Liber 2, Page 389 (Nov. 26, 1973)  
Found 1/2" iron  
SE cor blk bldg SW 69.76'  
NE cor blk bldg WNW 64.15'  
NW cor porch NE 70.55'  
SW cor hse ESE 57.86'  
C/L Byron Road N 107.2'±

B. Description of corner evidence found and/or method applied in restoring or reestablishing corner:

M-7 Found 1/2" iron pipe in gravel drive  
NE cor bldg (now alum. siding)  
SE cor bldg (now alum. siding)  
SW cor of house fndn (block)  
NW cor of brick porch pillar (lowest brick)  
Kent Co. Mon. in Mon. Box

N65°W 64.09'  
S60°W 69.70'  
S75°E 57.85'  
N60°E 70.55'  
North 118.16'

Accepted as a careful perpetuation of the position of the original corner.  
Replaced 1/2" iron with 24" x 3/4" iron rod and O.C. Cap.

P.A. 345 OTTAWA COUNTY


PEER APPROVED 11/21/94

*Rodney D. Unema*

C. Description of monument for corner and accessories established to perpetuate locating the position of the corner:

M-7 Corner Common to Sections 13 and 24  
Std. O.C. Cap on 24" x 3/4" iron bar (4" below surface of gravel driveway)  
NE cor bldg (now alum. siding)  
SE cor bldg (now alum. siding)  
SW cor of house fndn (block)  
NW cor of brick porch pillar (lowest brick)  
Kent Co. Mon. in Mon. Box (A-7, T5N, R12W)  
Set nail & O.C. tag in S side 20" Maple  
Set nail & O.C. tag in SE side 40" Maple

N65°W 64.09'  
S60°W 69.70'  
S75°E 57.85'  
N60°E 70.55'  
North 118.16'  
N85°E 25.63'  
N W 61.94'

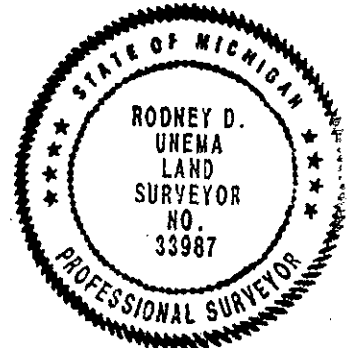

Signed by Rodney D. Unema

Date Nov. 17, 1994

Surveyor's Michigan License No. 33987