

SURVEY & REMONUMENTATION

APR 24 1995

OTTAWA COUNTY REMONUMENTATION

RECORDED

COMMISSION

LAND CORNER RECORDATION CERTIFICATE
Filing Requirement of Act 74, Mich. P.A. 1970

94 DEC 15 AM 11:45

For corners in
Ottawa

(County)

Located in:
Jamestown Township

Corner Code #

1. Public Land Survey	T	5N	R	13W	M-8
	T		R		
	T		R		
	T		R		
2. Property Controlling in Section	S		T	R	
	S		T	R	
3. Miscellaneous Property in Sec.	S		T	R	
	S		T	R	

Rodney D. Unema
REGISTER OF DEEDS
OTTAWA COUNTY, MI

Register of Deeds Stamp & File Number

4. Lot No. _____, Recorded Plat _____
5. Private Claims _____

	A	B	C	D	E	F	G	H	I	J	K	L	M
2	6	5	4	3	2	1							
3													
4	7	8	9	10	11	12							
5													
6	18	17	16	15	14	13							
7													
8	19	20	21	22	23	24							
9													
10	30	29	28	27	26	25							
11													
12	31	32	33	34	35	36							
13													

I, Rodney D. Unema, in a field survey on Nov. 12, 19 94, do hereby certify that under requirements of P.A. 74, Michigan P.A. of 1970, the corner points mentioned in lines 1 and 2 above were in conformance with regulations and rules therefore as required in the current manual of survey instructions of the United States Department of the Interior, Bureau of Land Management or by a decree of a Court of Law and/or that the corner points mentioned in lines 3, 4 and 5 above were in conformance with the rules of the Michigan Board of Land Surveyors or by a Decree of a Court of Law, established, re-established, monumented, re-monumented, recovered, found as expressed below:

NOTE: Not more than 4 corners, all in the same town and range, may be recorded on this certificate.

A. Description of original monument and accessories and/or subsequent restoration:

M-8 E 1/4 Corner, Section 24
Original gov't corner set on Oct. 18, 1831 by Lucius Lyon
Set H.W.P.
Beech 30" S57°W 18 links
Beech 4" N16°W 26 links

L.C.R.C. Liber 2, Pg. 389 (Nov. 26, 1973)
Found "L" iron
Nail in sde 12" Wild Cherry NE 31.47'
Nail in sde dbl. 24" Wild Cherry NW 49.48'
T iron (Byron Twp., cor) North 102.44'

B. Description of corner evidence found and/or method applied in restoring or reestablishing corner:

M-8 Found 3/4" iron pipe in N-S BT road (2" below BT) W 1/4 cor., Section 19, T5N, R12W North 102.78'
No other witnesses remaining
C/L of N-S BT West 5.5'

P.A. 345 OTTAWA COUNTY

PEER APPROVED 12/12/94


Rodney D. Unema

Accepted as a careful perpetuation of the position of the original corner, and replaced 3/4" iron with Std. O.C. Cap on 24" x 3/4" iron bar in new Mon. Box.

C. Description of monument for corner and accessories established to perpetuate locating the position of the corner:

M-8 E 1/4 Corner, Section 24
Std. O.C. Cap on 3/4" x 24" bar in Mon. Box
W 1/4 cor., Section 19, T5N, R12W (Kent County Remon)
Set nail & O.C. tag in W'y sde 10" Oak
Set nail & O.C. tag in N sde 30" Ash
NE cor house #1977 (cor of conc cap on top of brick)
C/L BT road (Kenowa Ave.)
Tree row to West

North 102.78'
N41°W 56.59'
N85°W 90.71'
S62°W 139.97'
West 5.5'

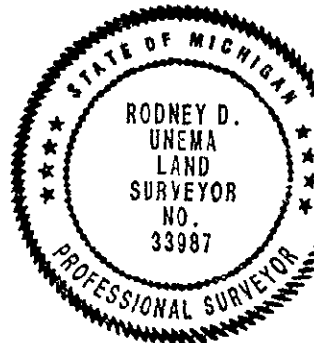

Signed by Rodney D. Unema

Date DEC. 12, 1994

Surveyor's Michigan License No. 33987

FORM APPROVED BY MICHIGAN STATE BOARD OF LAND SURVEYORS, JAN. 28, 19
REVISED MAY 14, 19
REVISED JAN., 19