

SURVEY & REMONUMENTATION

APR 25 1995

OTTAWA COUNTY REMONUMENTATION
LAND CORNER RECORDATION CERTIFICATE
Filing Requirement of Act 74, Mich. P.A. 1970

RECORDED

94 DEC -8 PM 12: 29

COMMISSION

Deborah S. Galtman
REGISTER OF DEEDS
OTTAWA COUNTY, MI

For corners in

Ottawa
(County)

Located In:

Corner Code #

Jamestown Township

- | | | | |
|------------------------------------|--------------------------|-------------|-------|
| 1. Public Land Survey | T <u>5N</u> R <u>13W</u> | <u>M-10</u> | |
| | T _____ R _____ | _____ | _____ |
| | T _____ R _____ | _____ | _____ |
| | T _____ R _____ | _____ | _____ |
| 2. Property Controlling in Section | S _____ T _____ R _____ | _____ | _____ |
| | S _____ T _____ R _____ | _____ | _____ |
| 3. Miscellaneous Property in Sec. | S _____ T _____ R _____ | _____ | _____ |
| | S _____ T _____ R _____ | _____ | _____ |

Register of Deeds Stamp & File Number

4. Lot No. _____, Recorded Plat _____
5. Private Claims _____

	A	B	C	D	E	F	G	H	I	J	K	L	M
2	6	5	4	3	2	1							
3													
4	7	8	9	10	11	12							
5													
6	13	17	16	15	14	13							
7													
8	19	20	21	22	23	24							
9													
10	30	29	28	27	26	25							
11													
12	31	32	33	34	35	36							
13													

Rodney D. Unema in a field survey on Nov. 12, 1994, do hereby certify that under requirements of P.A. 74, Michigan P.A. of 1970, the corner points mentioned in lines 1 and 2 above were in conformance with regulations and rules therefore as required in the current manual of survey instructions of the United States Department of the Interior, Bureau of Land Management or by a decree of a Court of Law and/or that the corner points mentioned in lines 3, 4 and 5 above were in conformance with the rules of the Michigan Board of Land Surveyors or by a Decree of a Court of Law; established, re-established, monumented, re-monumented, recovered, found as expressed below:

NOTE: Not more than 4 corners, all in the same town and range, may be recorded on this certificate.

A. Description of original monument and accessories and/or subsequent restoration:

M-10 E 1/4 Corner, Section 25

Original gov't corner set on Oct. 18, 1831,
by Lucius Lyon
Set H.W.P.
Beech 30" S57°W 17 links
Beech 4" N16°W 27 links

L.C.R.C. Liber 3, Page 2 (Dec. 11, 1975)
Found angle iron
Sq. spk in S side large triple Maple W 15.93'
Sq. spk in E side 10" Clump Maple SSW 9.55'
Sq. spk in W side twin 8" Cherry SSE 34.20'
Round iron (W 1/4 cor, Section 30, Byron Twp.
N 69.30'

3. Description of corner evidence found and/or method applied in restoring or reestablishing corner:

M-10
Found angle iron at W edge of N-S gravel road (Kenowa Ave.)
Found spk in S side 30" triple Maple N71°W 15.92'
Found spk in E side clump Maple S37°W 9.59'
W 1/4, Section 30, T5N, R12W, Kent County Remon. North 69.12'

Accepted position of angle iron as a careful perpetuation of original corner and replaced with Std. O.C. Cap on 24" x 3/4" iron bar.


P.A. 345 OTTAWA COUNTY

PEER APPROVED 11/21/94

C. Description of monument for corner and accessories established to perpetuate locating the position of the corner:

M-10 E 1/4 Corner, Section 25
Std. O.C. Cap on 24" x 3/4" iron bar
At W edge of N-S gravel Road (Kenowa Ave.)
W 1/4 corner, Section 30, T5N, R12W
Set nail & O.C. tag in S side 30" triple Maple
Set nail & O.C. tag in SE side 16" Maple
Set nail & O.C. tag in N side 12" Ash
Set nail & O.C. tag in SW side 14" Ash
Old fence row to West

North 69.12'
N71°W 15.92'
S71°W 45.42'
N79°E 25.73'
S31°E 45.18'

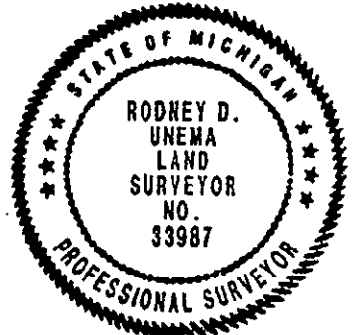

Signed by Rodney D. Unema

Date Nov. 17, 1994

Surveyor's Michigan License No. 33987