

SURVEY & REMONUMENTATION

OTTAWA COUNTY REMONUMENTATION

APR 25 1995

LAND CORNER RECORDATION CERTIFICATE
Filing Requirement of Act 74, Mich. P.A. 1970

RECORDED

94 DEC -8 PM 12:29

Edy... [Signature]
REGISTER OF DEEDS
OTTAWA COUNTY, MI

For corners in **COMMISSION**

<u>Ottawa</u> <small>(County)</small>	Located In: Jamestown Township	Corner Code #: M-11
1. Public Land Survey	T <u>5N</u> R <u>13W</u>	<u>M-11</u>
	T _____ R _____	_____
	T _____ R _____	_____
	T _____ R _____	_____
2. Property Controlling in Section	S _____ T _____ R _____	_____
	S _____ T _____ R _____	_____
3. Miscellaneous Property in Sec.	S _____ T _____ R _____	_____
	S _____ T _____ R _____	_____

Register of Deeds Stamp & File Number

4. Lot No. _____, Recorded Plat _____
5. Private Claims _____

I, Rodney D. Unema, in a field survey on Nov. 16, 19 94, do hereby certify that under requirements of P.A. 74, Michigan P.A. of 1970, the corner points mentioned in lines 1 and 2 above were in conformance with regulations and rules therefore as required in the current manual of survey instructions of the United States Department of the Interior, Bureau of Land Management or by a decree of a Court of Law and/or that the corner points mentioned in lines 3, 4 and 5 above were in conformance with the rules of the Michigan Board of Land Surveyors or by a Decree of a Court of Law; established, re-established, monumented, re-monumented, recovered, found as expressed below:

	A	B	C	D	E	F	G	H	I	J	K	L	M
2	6	5	4	3	2	1							
3													
4	7	8	9	10	11	12							
5													
6	18	17	16	15	14	13							
7													
8	19	20	21	22	23	24							
9													
10	30	29	28	27	26	25							
11													
12	31	32	33	34	35	36							
13													

NOTE: Not more than 4 corners, all in the same town and range, may be recorded on this certificate.

A. Description of original monument and accessories and/or subsequent restoration:

M-11 Corner Common to Sections 25 and 36		**see other side
Original gov't corner set on Oct. 18, 1831 by Lucius Lyon	L.C.R.C. Liber 1, Page 135 (Nov. 8, 1971)	L.C.R.C. Liber 3, Page 359 (July 2, 1979)
Set post	Mon. Box	Iron in Mon. Box
Birch 10" S18°W 17 links	C/L street sign SW 48.50'	Spk in sde 30" Maple WSW 122.51'
Birch 11" N34°W 34 links	48" Maple NW 43.35'	Spk in sde 36" Maple NW 45.45'
		Spk in sde 14" Maple NNE 95.30'
		C/L blacktop North 6.7'
		C/L street sign SW 45.7'

B. Description of corner evidence found and/or method applied in restoring or reestablishing corner:

M-11
Found 3" dia. Cast Iron Mon. in Mon. Box at intersection of Kenowa Ave. and Adams St.
Top center of corr. culvert S80°E 68.09'
Center of 18" Elm N21°W 86.36'
Center of 24" Maple N15°E 94.94'
Center of street sign S37°W 45.89'


Accepted as a careful perpetuation of the position of the original corner.

P.A. 345 OTTAWA COUNTY

PEER APPROVED 11/21/94

C. Description of monument for corner and accessories established to perpetuate locating the position of the corner:

M-11 Corner Common to Sections 25 and 36	
3" dia. Cast Iron Mon. in Mon. Box at intersection of Kenowa Ave. and Adams St.	
Set nail & O.C. tag in E side 18" Elm	N21°W 86.36'
Set nail & O.C. tag in W side 24" Maple	N15°E 94.94'
Set nail & O.C. tag in N side 36" Maple	S73°W 122.21'
Punch mark in top center of 36' corr. culvert	S80°E 68.09'
NW cor., Section 31, T5N, R12W (Kent Co. remon)	North 60.53'

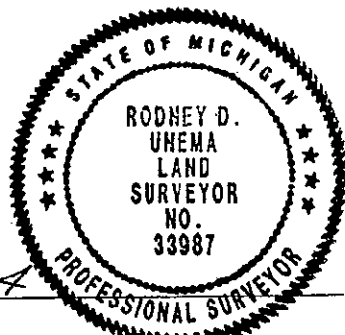

Signed by Rodney D. Unema

Date Nov. 18, 1994

Surveyor's Michigan License No. 33987

OTTAWA

Section A (con't)

L.C.R.C. Liber 5, Page 188 (Dec. 27, 1984)
Set cast iron Mon.
14" Ash NW 85.79'
16" Maple NE 95.27'
Street sign SW 45.75'
Top center of corr. culv SE 68.15'

1655
3500
3500
3500

130
007
007
007