

**Ottawa County Remonumentation  
LAND CORNER RECORDATION CERTIFICATE  
Filing Requirement of Act 74, Mich. P.A. 1970**

For corners in  
Ottawa  
(County)

Located In: \_\_\_\_\_ Corner Code # \_\_\_\_\_

- |                                    |                          |                       |
|------------------------------------|--------------------------|-----------------------|
| 1. Public Land Survey              | T <u>5N</u> R <u>14W</u> | <u>A-2 (W 1/4, 6)</u> |
|                                    | T _____ R _____          | <u>Zeeland Twp.</u>   |
|                                    | T _____ R _____          | _____                 |
|                                    | T _____ R _____          | _____                 |
| 2. Property Controlling in Section | S _____ T _____ R _____  | _____                 |
|                                    | S _____ T _____ R _____  | _____                 |
| 3. Miscellaneous Property in Sec.  | S _____ T _____ R _____  | _____                 |
|                                    | S _____ T _____ R _____  | _____                 |

**RECORDED**

96 DEC 17 AM 10:44

*Richard A. ...*  
REGISTER OF DEEDS  
OTTAWA COUNTY, MI

Register of Deeds Stamp & File Number

4. Lot No. \_\_\_\_\_, Recorded Plat \_\_\_\_\_  
5. Private Claims \_\_\_\_\_

	A	B	C	D	E	F	G	H	I	J	K	L	M
2	6	5	4	3	2	1							
3													
4	7	8	9	10	11	12							
5													
6	18	17	16	15	14	13							
7													
8	19	20	21	22	23	24							
9													
10	30	29	28	27	26	25							
11													
12	31	32	33	34	35	36							
13													

I, John C. Bueche, in a field survey on October 21, 19 96, do hereby certify that under requirements of P.A. 74, Michigan P.A. of 1970, the corner points mentioned in lines 1 and 2 above were in conformance with regulations and rules therefore as required in the current manual of survey instructions of the United States Department of the Interior, Bureau of Land Management or by a decree of a Court of Law and/or that the corner points mentioned in lines 3, 4 and 5 above were in conformance with the rules of the Michigan Board of Land Surveyors or by a Decree of a Court of Law; established, re-established, monumented, re-monumented, recovered, found as expressed below:

**NOTE: Not more than 4 corners, all in the same town and range, may be recorded on this certificate.**

**A. Description of original monument and accessories and/or subsequent restoration:**

A-2 GLO Not set	LCRC L1, P363 May 4, 1972 PK SW cor. att. gar. NE 116.16' Nail in face TP SW 54.82' Nail in face GP SE 51.89' NW cor. hse. SE 101.81' Brass Plug Holland Twp. cor. N 111.50'	LCRC L3, P83 April 9, 1976 Sq. Iron PK SW side GP S 35° E 52.40' PK SE TP S 40° W 55.22' PK SE 10" Maple N 50° E 79.07' PK top cor. fence post N 25° W 116.94'
--------------------	---	--

OVER

**B. Description of corner evidence found and/or method applied in restoring or reestablishing corner:**

A-2 Found Ottawa Co. Mon. (4" Harrison in Mon. Box) on the 0.12 West of Twp. Line  
SW cor. att. gar. NE 116.16' On C/L bit. N-S & E  
NW cor. hse. SE 101.81'

GLO from SW 6 to NW 6 80.00 + 1.37 falling South of SE 1  
Meas. North to NW 6 2752.77' (GLO pro. 2741.87')  
Meas. South to SW 6 2640.18' (GLO pro. 2651.08')

This position not established by government surveyors. This monument is accepted as the best available evidence of the position of the corner.

**C. Description of monument for corner and accessories established to perpetuate locating the position of the corner:**

A-2 Ottawa Co. Mon. (4" Harrison) in Mon. Box  
Nail & Ottawa Co. Remon. Tag in N side of PP West 25.83'  
Nail & Ottawa Co. Remon. Tag in top post @ MBT Box S 39° W 54.75'  
SW cor. brick garage N 64° E 116.18'  
NW cor. hse. fnd. S 49° E 101.95'  
Ottawa Co. Mon. (4" Harrison) in Mon. Box North 111.40' (E 1/4 cor. Sec. 1, 5-15)  
On C/L bit. N-S & E

\$ 11.00 CORNER  
\$ 1.00 PHOTO  
\$ 1.00 PHOTO


P.A. 345 OTTAWA COUNTY

PEER APPROVED 11-11-96

Signed by John C. Bueche  
John C. Bueche, P.S.

Date 11-7-96

Surveyor's Michigan License No. 13027

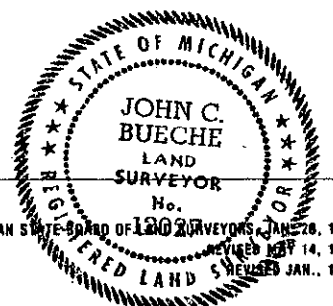

FORM APPROVED BY MICHIGAN STATE BOARD OF LAND SURVEYORS, JAN. 28, 1971  
REVISED MAY 14, 1975  
REVISED JAN., 1983

A-2  
 LCRC L6, P18  
 Oct. 17, 1989 Set CIM  
 Nail SE side 16" Maple NE 79.07'  
 PK TP SW 55.22'  
 PK GP SE 52.40'  
 E 1/2 cor. Sec. 1, 5-15 N 111.38'

