

**Ottawa County Remonumentation
LAND CORNER RECORDATION CERTIFICATE
Filing Requirement of Act 74, Mich. P.A. 1970**

For corners in

Ottawa

(County)

Located in:

Corner Code #

- | | | |
|------------------------------------|--------------------------|-----------------------|
| 1. Public Land Survey | T <u>5N</u> R <u>14W</u> | <u>B-1 (N 1/4, 6)</u> |
| | T _____ R _____ | <u>Zeeland Twp.</u> |
| | T _____ R _____ | _____ |
| | T _____ R _____ | _____ |
| 2. Property Controlling in Section | S _____ T _____ R _____ | _____ |
| | S _____ T _____ R _____ | _____ |
| 3. Miscellaneous Property in Sec. | S _____ T _____ R _____ | _____ |
| | S _____ T _____ R _____ | _____ |

RECORDED

96 DEC 17 AM 10:44

Robert R. Alderson
REGISTER OF DEEDS
OTTAWA COUNTY, MI

Register of Deeds Stamp & File Number

4. Lot No. _____, Recorded Plat _____
5. Private Claims _____

	A	B	C	D	E	F	G	H	I	J	K	L	M
2	6	5	4	3	2	1							
3													
4	7	8	9	10	11	12							
5													
6	18	17	16	15	14	13							
7													
8	19	20	21	22	23	24							
9													
10	30	29	28	27	26	25							
11													
12	31	32	33	34	35	36							
13													

I, John C. Bueche, in a field survey on October 17, 1996, do hereby certify that under requirements of P.A. 74, Michigan P.A. of 1970, the corner points mentioned in lines 1 and 2 above were in conformance with regulations and rules therefore as required in the current manual of survey instructions of the United States Department of the Interior, Bureau of Land Management or by a decree of a Court of Law and/or that the corner points mentioned in lines 3, 4 and 5 above were in conformance with the rules of the Michigan Board of Land Surveyors or by a Decree of a Court of Law; established, re-established, monumented, re-monumented, recovered, found as expressed below:

NOTE: Not more than 4 corners, all in the same town and range, may be recorded on this certificate.

A. Description of original monument and accessories and/or subsequent restoration:

- | | | |
|---------|--------------------------------|------------------------------|
| B-1 GLO | LCRC L1, P363 | LCRC L3, P83 |
| Not set | May 4, 1972 "T" iron | April 9, 1976 "T" iron |
| | "T" iron Blendon Twp. E 46.86' | Nail & cap W side TP N 45° E |
| | Nail in face PP SW 131.66' | 51.61' |
| | Nail in face TP NW 104.20' | PK S side TP N 70° W 104.38' |
| | SW cor. hse. #9175 NE 123.90' | PK N side PP S 45° W 132.13' |
| | C/L MH NE 26.94' | |

OVER

B. Description of corner evidence found and/or method applied in restoring or reestablishing corner:

B-1 Found Ottawa Co. Mon. (4" Harrison) in gravel road down 0.8'
As per above wit.

GLO SW 31 to SE 31 85.75 (5659.50', GLO falling 71 (46.86' W of SE 31)
Meas. West to NW cor. 6 2962.37' (GLO pro. 2970.05')
Meas. East to NE cor. 6 2645.37' (GLO pro. 2637.70')

This position not established by original government surveyors. This monument is accepted as the best available evidence of the position of the corner.

P.A. 345 OTTAWA COUNTY


PEER APPROVED

11-11-96
[Signature]

C. Description of monument for corner and accessories established to perpetuate locating the position of the corner:

- B-1 Ottawa Co. Mon. (4" Harrison) in gravel road
- Nail & Ottawa Co. Remon. Tag in S side PP N 30° W 83.05'
 - Nail & Ottawa Co. Remon. Tag in S side PP S 60° W 132.33'
 - Nail & Ottawa Co. Remon. Tag in E side dbl. 18" Ash S 5° W 72.55'
 - Nail & Ottawa Co. Remon. Tag in SW side 10" Ash S 70° W 75.35'
 - Nail & Ottawa Co. Remon. Tag in W tri. 12" Ash N 49° E 64.54'
 - SW cor. of hse. N 56° E 123.97'
 - On gravel road E-W, on tree line South
 - C/L drive North, West 15'
 - Ottawa Co. Mon. East 47.00' S 1/4 Sec. 31, 6-14

\$ 11.00 CORNER
\$ 1.00 PHOTO
\$ 1.00 PHOTO

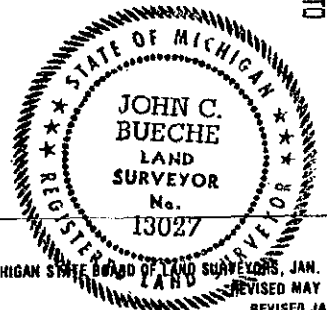

Signed by John C. Bueche
John C. Bueche, P.S. 13027
Surveyor's Michigan License No. _____

Date 11-7-96

B-1
 LCRC L4, P207
 June 25, 1981 cast iron mon.
 10" Tree S 72.72'
 2" steel post NNE 28.33'
 6" Tree NE 64.92'
 Blendon cor. E 46.98'

Zeeland Twp

