

FEB 24 2000

OTTAWA COUNTY REMONUMENTATION
LAND CORNER RECORDATION CERTIFICATE
Filing Requirement of Act 74, Mich. P.A. 1970

RECORDED
99 SEP 23 PM 3: 21

Dans Sublette
REGISTER OF DEEDS
OTTAWA COUNTY, MI

For corners in SECTION

| | | |
|------------------------------------|---------------------------------|----------------------------|
| Ottawa (County) | Located In: Zeeland Township | Corner Code # B-5 |
| 1. Public Land Survey | T 5N R 14W T R T R T R | N 1/4 corner Section 18 |
| 2. Property Controlling in Section | S T R S T R | |
| 3. Miscellaneous Property in Sec. | S T R S T R | |

Register of Deeds Stamp & File Number

4. Lot No. _____, Recorded Plat _____
5. Private Claims _____

I, Rodney D. Unema, in a field survey on August 27, 1999 do hereby state that under requirements of P.A. 74, Michigan P.A. of 1970, the corner points mentioned in lines 1 and 2 above were in conformance with regulations and rules therefore as required in the current manual of survey instructions of the United States Department of the Interior, Bureau of Land Management or by a decree of a Court of Law and/or that the corner points mentioned in lines 3, 4 and 5 above were in conformance with the rules of the Michigan Board of Land Surveyors or by a Decree of a Court of Law; established, re-established, monumented, recovered, found as expressed below:

NOTE: Not more than 2 corners, all in the same town and range, may be recorded on this certificate.

| | | | | | | | | | | | | |
|----|---|----|---|----|---|----|---|----|---|----|---|----|
| 1 | A | B | C | D | E | F | G | H | I | J | K | L |
| 2 | | 6 | | 5 | | 4 | | 3 | | 2 | | 1 |
| 3 | | | | | | | | | | | | |
| 4 | | 7 | | 8 | | 9 | | 10 | | 11 | | 12 |
| 5 | | | | | | | | | | | | |
| 6 | | 18 | | 17 | | 16 | | 15 | | 14 | | 13 |
| 7 | | | | | | | | | | | | |
| 8 | | 19 | | 20 | | 21 | | 22 | | 23 | | 24 |
| 9 | | | | | | | | | | | | |
| 10 | | 30 | | 29 | | 28 | | 27 | | 26 | | 25 |
| 11 | | | | | | | | | | | | |
| 12 | | 31 | | 32 | | 33 | | 34 | | 35 | | 36 |
| 13 | | | | | | | | | | | | |

A. Description of original monument and accessories and/or subsequent restoration:

B-5 1/4 Corner between Sections 7 and 18

| | | | |
|--|--|---|--|
| April, 1832 G.L.O. Survey by C. Britain Set 1/2 mile post 20" Hemlock S19°E 18 links 10" Hemlock N76°W 30 links | Jan. 9, 1973 (Englert) Liber 1, page 823 Found 1" pipe N to P.P. 37.55' S to P.P. 40.22' S to 12" Oak 31.4' S to 24" Sycamore 53.83' | Feb. 16, 1973 (Clapp) Liber 2, page 47 Found bent 7 iron, set steel bar P.Pole N 37.55' 10" Hickory S 31.26' P.Pole S 40.20' 8" Sycamore S 54.74' | March 23, 1973 (Roon) Liber 2, page 81 Found steel rod, set cast iron mon. 12" Oak S 31.30' P.Pole S 40.20' 24" Sycamore S 53.82' P.Pole N 37.51' NE cor. bldg SSW 86.47' |
|--|--|---|--|

B. Description of corner evidence found and/or method applied in restoring or reestablishing corner:


B-5 Found PK nail on centerline of Riley
24" Sycamore (center of tree) South 55.35'
NE corner of building S15°W 86.48'

The position of the PK nail checks with previous 1/2 mile measurements by Exxel Engineering in Sept. 1989. (see sketch on back of cert.) Accepted the position of the PK nail as a careful and faithful perpetuation of the position of the original corner, and replaced with standard Ottawa County Cap on 24" x 3/4" steel bar, in new monument box.

C. Description of monument for corner and accessories established to perpetuate locating the position of the corner:

B-5 1/4 corner between Sections 7 and 18
Ottawa County Cap on 3/4" x 24" bar in mon. box

| | |
|--|---------------|
| Set O.C. remon nail & tag in E sde of P.Pole | S10°E 30.04' |
| Set O.C. remon nail & tag in E sde of P.Pole | North 137.91' |
| Set O.C. remon nail & tag in N sde of P.Pole | S80°W 170.15' |
| NE cor of brick bldg | S60°E 300.51' |
| on Centerline of E-W bt road (Riley) | East 10' |
| Centerline gravel road to North (92nd Ave) | S15°W 86.48' |
| NE cor. bldg (conc. wall) | |

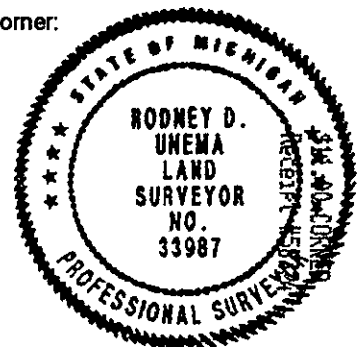

Signed by Rodney D. Unema
Surveyor's Michigan License No. 33987

Date August 30, 1999

FEB 24 2000

SECTION

