

RECORDED

99 SEP 23 PM 3: 21

FEB 24 2000

OTTAWA COUNTY REMONUMENTATION
LAND CORNER RECORDATION CERTIFICATE
Filing Requirement of Act 74, Mich. P.A. 1970

Gary Sublette
REGISTER OF DEEDS
OTTAWA COUNTY, MI

For corners in SECTION

Ottawa (County)	Located In: Zeeland Township	Corner Code #
1. Public Land Survey	T 5N R 14W	B-7
	T R	N 1/4 Corner
	T R	Section 19
	T R	
2. Property Controlling in Section	S T R	
	S T R	
3. Miscellaneous Property in Sec.	S T R	
	S T R	

Register of Deeds Stamp & File Number

4. Lot No. _____, Recorded Plat _____
5. Private Claims _____

I, Rodney D. Unema, in a field survey on August 27, 1999 do hereby state that under requirements of P.A. 74, Michigan P.A. of 1970, the corner points mentioned in lines 1 and 2 above were in conformance with regulations and rules therefore as required in the current manual of survey instructions of the United States Department of the Interior, Bureau of Land Management or by a decree of a Court of Law and /or that the corner points mentioned in lines 3, 4 and 5 above were in conformance with the rules of the Michigan Board of Land Surveyors or by a Decree of a Court of Law; established, re-established, monumented, recovered, found as expressed below.

NOTE: Not more than 2 corners, all in the same town and range, may be recorded on this certificate.

1	A	B	C	D	E	F	G	H	I	J	K	L	I
2	6		5		4		3		2		1		
3													
4	7		8		9		10		11		12		
5													
6	18		17		16		15		14		13		
7	▲												
8	19		20		21		22		23		24		
9													
10	30		29		28		27		26		25		
11													
12	31		32		33		34		35		36		
13													

A. Description of original monument and accessories and/or subsequent restoration:

B-7 1/4 Corner between Sections 18 and 19

April, 1832 G.L.O. Survey
by C. Britain
Set 1/2 mile post
30" Maple S35°E 12 links
10" Hemlock N5°W 19 links

Oct. 7, 1971 (Greer)
Liber 1, page 103
Found 1" iron pipe
NW to bldg corner 55.63'
NE to bldg corner 56.50'
N to centerline Main Street 13.50'
S30°E to P. pole 82.23'
S70°W to P. pole 99.20'
S40°E to P. pole 7.18'

July 27, 1979 (VanOrder) *Con't over
Liber 3, page 378
Found 1" iron pipe
Bldg corner NW 55.03'
Bldg corner NE 56.50'
Centerline Main Street N 13.50'
P. pole S30°E 82.23'
P. pole S70°W 99.20'
P. pole S40°E 7.18'

B. Description of corner evidence found and/or method applied in restoring or reestablishing corner:

B-7 No Section Corner Found

*Over for Sketch

Only remaining witness of record - SE cor brick bldg N16°W 55.56'
Used information and witnesses (unrecorded) from Holland Engineering, Nederveld Associates, and Exxel Engineering to re-establish position of corner.


Found PK in E sde of P. pole N19°E held 70.97'
Found PK in S. sde of P. pole S85°E held 67.25'
C-7 NE corner, Section 19 East 2620.13'

Accepted as a careful and faithful perpetuation of the position of the original corner, and set Ottawa County Cap on 3/4" x 24" steel bar in new monument box.

C. Description of monument for corner and accessories established to perpetuate locating the position of the corner:

B-7 1/4 Corner between Sections 18 and 19
Ottawa Co. Cap on 3/4" x 24" steel bar in monument box.

Set O.C. reron nail & tag in N sde P. pole S85°E 67.65'
Set O.C. reron nail & tag in W sde P. pole S15°E 64.40'
Set O.C. reron nail & tag in W sde P. pole N20°E 70.91'
NE cor brick bldg S55°W 153.10'
SE bldg cor N20°W 55.56'
Centerline E-W bt road (Main St.) North 16'
Centerline bt road to South (Maple St.) East 37'
Centerline bt road to North East 2'

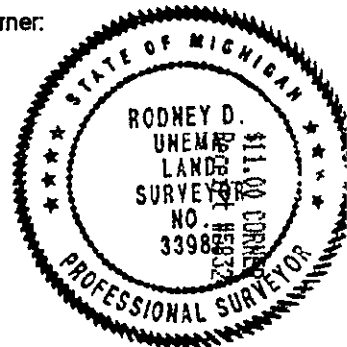

Signed by Rodney D. Unema
Surveyor's Michigan License No. 33987

Date 8/30/99
August 30, 1999

FEB 24 2000

SECTION

Feb. 1996 Nederveid (unrecorded)
S 1/4 corner (Set P.K. w/sasher)

SE cor brk bldg	N16°W	55.52'
Fnd PK in E. sde P. pole	N19°E	70.97'
Fnd PK in S. sde P. pole	S85°E	67.25'
Fnd RLS #14091 Nail & tag W. sde P. Pole	S14°E	64.67'
PK on E. seam	North	16.70'

