

FEB 24 2000

OTTAWA COUNTY REMONUMENTATION

RECORDED

99 SEP 23 PM 3:21

SECTION

LAND CORNER RECORDATION CERTIFICATE  
Filing Requirement of Act 74, Mich. P.A. 1970

*Dan Sullivan*  
REGISTER OF DEEDS  
OTTAWA COUNTY, MI

For corners in

Ottawa

(County)

Located In:

Zeeland Township

Corner Code #

1. Public Land Survey

T 5N R 14W

B-9

T R

N 1/4 corner

T R

Section 30

T R

2. Property Controlling  
in Section

S T R

S T R

3. Miscellaneous  
Property in Sec.

S T R

S T R

Register of Deeds Stamp & File Number

4. Lot No. \_\_\_\_\_, Recorded Plat \_\_\_\_\_

5. Private Claims \_\_\_\_\_

I, Rodney D. Unema, in a field survey on August 27, 1999 do hereby state that under requirements of P.A. 74, Michigan P.A. of 1970, the corner points mentioned in lines 1 and 2 above were in conformance with regulations and rules therefore as required in the current manual of survey instructions of the United States Department of the Interior, Bureau of Land Management or by a decree of a Court of Law and/or that the corner points mentioned in lines 3, 4 and 5 above were in conformance with the rules of the Michigan Board of Land Surveyors or by a Decree of a Court of Law; established, re-established, monumented, recovered, found as expressed below:

NOTE: Not more than 2 corners, all in the same town and range, may be recorded on this certificate.

A	B	C	D	E	F	G	H	I	J	K	L
1											
2	6	5	4	3	2	1					
3											
4	7	8	9	10	11	12					
5											
6	18	17	16	15	14	13					
7											
8	19	20	21	22	23	24					
9	▲										
10	30	29	28	27	26	25					
11											
12	31	32	33	34	35	36					
13											

A. Description of original monument and accessories and/or subsequent restoration:

B-9 1/4 Corner between Sections 19 and 30

March 1832 G.L.O. Survey

by C. Britain

Set 1/2 mile post

12" Cedar N50°E 10 links

12" Hemlock N85°W 9 links

Dec. 11, 1975 (Nederveld)

Liber 3, page 4

Found iron

SE cor brick garage SW 121.05'

SE cor brick house NW 104.75'

SW cor garage fndn NE 94.53'

March 15, 1988 (Brintnall)

Liber 5, page 286

Set O.C. cast iron mon.

NW 35.52' Nail & washer in NE sde of PP

N 100.01' PK in C/L of Road ROW

NNE 84.87' PK in the W sde of 14" Elm

ENE 94.48' SW cor of block garage fndn

S 23.95' Nail & washer in the W sde of PP

\*\*Continued on back side\*\*

B. Description of corner evidence found and/or method applied in restoring or reestablishing corner:

B-9 Found PK nail in blacktop at intersection of 92nd & Perry

SE cor brick garage

SW 141.64'

SE cor brick house

NW 104.69'

Nail & washer in W sde P.Pole

South 24.02'

Centerline san. MH

N80°W 8.95'

Accepted as a careful and faithful perpetuation of the position of the original corner, and replaced PK nail with Ottawa Co. Cap on 3/4" x 24" steel bar in new monument box.

8/30/99  
*YD*

C. Description of monument for corner and accessories established to perpetuate locating the position of the corner:

B-9 1/4 corner between Sections 19 and 30  
Ottawa Co. Cap on 3/4" x 24" steel bar in monument box

Set O.C. remon nail & tag in S sde P.Pole

N80°E 172.78'

Set O.C. remon nail & tag in E sde P.Pole

N5°W 155.14'

MSHD nail & tag in W sde P.Pole

South 24.02'

SE cor brick garage

S30°W 141.64'

SE cor brick house


N50°W 104.69'

C/L bt road to North (92nd Ave)

East 1'

C/L bt road to East (Perry St.)

North 12'

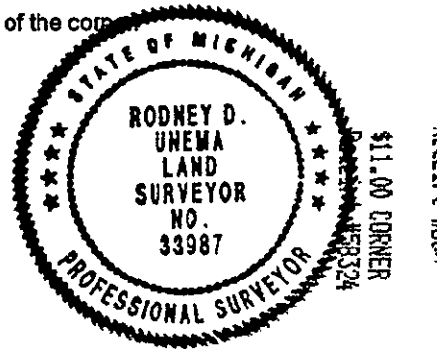

Signed by Rodney D. Unema  
Surveyor's Michigan License No. 33987

Date August 30, 1999

FEB 24 2000

SECTION

March 18, 1988 (Greer)

Liber 5, page 296

Found conc. monument

SE cor brick garage	SW	141.65'
SE cor brick hse	NW	104.73'
SW cor brick hse	NW	126.38'
NW cor hse fnd.	NE	135.37'
SW cor hse fnd.	NE	102.42'

Dec. 30, 1996 (Root)

Liber 8 of Surveys, Page 809

PK nail at S 1/4 corner

Fnd nail & MSHD tag in W sde P. pole

Fnd nail & MSHD tag in NE sde P. pole

SW cor. block garage fndn.

C/L san MH

South	23.94'
N50°W	43.01'
N50°E	94.50'
N80°W	8.95'