

RECORDED

Ottawa County Remonumentation  
LAND CORNER RECORDATION CERTIFICATE  
Filing Requirement of Act 74, Mich. P.A. 1970

97 JUL 24 PM 2: 24

*Elizabeth Anderson*  
REGISTER OF DEEDS  
OTTAWA COUNTY, MI

For corners in

Ottawa

(County)

Located In:

Corner Code #

- 1. Public Land Survey      T 5N R 14W      B-13 (S $\frac{1}{2}$ , 31)  
    T \_\_\_\_\_ R \_\_\_\_\_      Zeeland Twp.  
    T \_\_\_\_\_ R \_\_\_\_\_  
    T \_\_\_\_\_ R \_\_\_\_\_
- 2. Property Controlling    S \_\_\_\_\_ T \_\_\_\_\_ R \_\_\_\_\_  
    in Section                    S \_\_\_\_\_ T \_\_\_\_\_ R \_\_\_\_\_
- 3. Miscellaneous            S \_\_\_\_\_ T \_\_\_\_\_ R \_\_\_\_\_  
    Property in Sec.            S \_\_\_\_\_ T \_\_\_\_\_ R \_\_\_\_\_

Register of Deeds Stamp & File Number

- 4. Lot No. \_\_\_\_\_, Recorded Plat \_\_\_\_\_
- 5. Private Claims \_\_\_\_\_

	A	B	C	D	E	F	G	H	I	J	K	L	M
2	6	5	4	3	2	1							
3													
4	7	8	9	10	11	12							
5													
6	18	17	16	15	14	13							
7													
8	19	20	21	22	23	24							
9													
10	30	29	28	27	26	25							
11													
12	31	32	33	34	35	36							
13													

I, John C. Bueche, in a field survey on April 1, 19 97, do hereby certify that under requirements of P.A. 74, Michigan P.A. of 1970, the corner points mentioned in lines 1 and 2 above were in conformance with regulations and rules therefore as required in the current manual of survey instructions of the United States Department of the Interior, Bureau of Land Management or by a decree of a Court of Law and/or that the corner points mentioned in lines 3, 4 and 5 above were in conformance with the rules of the Michigan Board of Land Surveyors or by a Decree of a Court of Law; established, re-established, monumented, re-monumented, recovered, found as expressed below:

NOTE: Not more than 4 corners, all in the same town and range, may be recorded on this certificate.

A. Description of original monument and accessories and/or subsequent restoration:

B-13	LCRC L3, P106
GLO Nov., 1831	Set cast iron mon., Aug., 1976
Lucius Lyon, DS	Trans. pole NW 126.90'
Set HMP	Power pole NE 62.43'
Beech 24 N 42 E 16	Iron N 33.00'
W. Ash 14 N 88 W 39	Overisel Twp. cor. W 100.3'

B. Description of corner evidence found and/or method applied in restoring or reestablishing corner:

B-13  
 Fnd. cast iron mon. in Mon. Box (4" Harrison)  
 Trans. pole NW 126.90'  
 Power pole NE 62.43'  
 Iron N 33.00'  
 Overisel Twp. cor. W 100.3'

P.A. 345 OTTAWA COUNTY  
PEER APPROVED 4/21/97

And is accepted as a careful and faithful perpetuation of the position of the original corner.


C. Description of monument for corner and accessories established to perpetuate locating the position of the corner:

B-13 Cast iron mon. in Mon. Box (4" Harrison)  
 Nail & Tag (RLS 14091 4' high) E side PP N 30° W 126.88'  
 Nail & Tag (RLS 14091 4' high) E side PP N 71° E 62.31'  
 Nail & Ottawa Co. Remon. Tag in N side 10" Elm S 72° W 106.22'  
 Nail & Ottawa Co. Remon. Tag in W side 12" Elm N 1° E 67.32'  
 C/L E-W bit. rd. N 1'±, on tree row North  
 C/L gravel dr. N, West 12'±, C/L bit. dr. N, East 37'±  
 Overisel Twp. cor. West 100.3'

4 9.00 CORNER

Signed by John C. Bueche  
John C. Bueche, P.S.  
Surveyor's Michigan License No. 13027

Date 4-16-97

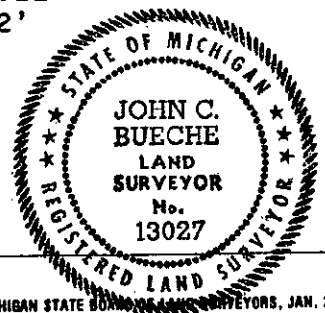

FORM APPROVED BY MICHIGAN STATE BOARD OF LAND SURVEYORS, JAN. 28, 1971  
REVISED MAY 14, 1975  
REVISED JAN., 1983