

**Ottawa County Remonumentation
LAND CORNER RECORDATION CERTIFICATE
Filing Requirement of Act 74, Mich. P.A. 1970**

For corners in

Ottawa

(County)

Located In:

Corner Code #

1. Public Land Survey	T <u>5N</u> R <u>14W</u>	<u>C-1 (NW, 5)</u>
	T _____ R _____	<u>Zeeland Twp.</u>
	T _____ R _____	_____
	T _____ R _____	_____
2. Property Controlling in Section	S _____ T _____ R _____	_____
	S _____ T _____ R _____	_____
3. Miscellaneous Property in Sec.	S _____ T _____ R _____	_____
	S _____ T _____ R _____	_____

RECORDED

96 DEC 17 AM 10:44

Elizabeth C. Blodgett
REGISTER OF DEEDS
OTTAWA COUNTY, MI

Register of Deeds Stamp & File Number

4. Lot No. _____, Recorded Plat _____
5. Private Claims _____

A	B	C	D	E	F	G	H	I	J	K	L	M
2	6	5	4	3	2	1						
3												
4	7	8	9	10	11	12						
5												
6	18	17	16	15	14	13						
7												
8	19	20	21	22	23	24						
9												
10	30	29	28	27	26	25						
11												
12	31	32	33	34	35	36						
13												

I, John C. Bueche, in a field survey on October 17, 19 96, do hereby certify that under requirements of P.A. 74, Michigan P.A. of 1970, the corner points mentioned in lines 1 and 2 above were in conformance with regulations and rules therefore as required in the current manual of survey instructions of the United States Department of the Interior, Bureau of Land Management or by a decree of a Court of Law and/or that the corner points mentioned in lines 3, 4 and 5 above were in conformance with the rules of the Michigan Board of Land Surveyors or by a Decree of a Court of Law; established, re-established, monumented, re-monumented, recovered, found as expressed below:

NOTE: Not more than 4 corners, all in the same town and range, may be recorded on this certificate.

A. Description of original monument and accessories and/or subsequent restoration:

C-1 GLO LCRC L1, P363	LCRC L3, P83
Lucius Lyon May 4, 1972 stone	April 28, 1976 CIM
DS, 1831 Set cast iron mon.	PK N side TP S 40° W 42.03'
N. Boundary Nail in face guardrail post	Nail & cap S side TP N 50° E
71 W of NW 20.70'	88.08'
post Secs. Nail in face PP S 10° E 197.99'	C/L USGS BM S 03° W 22.05'
5 & 6 Nail in face TP SW 41.77'	NW cor. .5' x 10' conc. hdwl.
Pine 10 S Nail in face TP NE 87.81'	S 40° E 27.75'
.37 E 33 X SW cor. hdwl. SW 32.02'	
Pine 10 S, Blendon Twp. cor. E 46.48'	

B. Description of corner evidence found and/or method applied in restoring or reestablishing corner:

C-1 Found Ottawa Co. Mon. (4" Harrison) in gravel road down 0.8'
As per above wit.

This mon. is 0.47' North of South Line of Township,
GLO falling 71 (46.86' W of SE 31) Meas. 46.70'

And is accpeted as a careful and faithful perpetuation of the position
of the original corner.

RA. 045 OTTAWA COUNTY


PEER APPROVED 11-11-96

J.C.B.

C. Description of monument for corner and accessories established to perpetuate locating the position of the corner:

C-1 Set Ottawa Co. Mon. (3/4" x 24" pin with cap) on South Line of
Township Left Harrison Mon.
NW cor. 4.5' x 5' steel lid to MICHCON MH N 66° E 77.21'
Nail & Ottawa Co. Remon. Tag in E side PP N 05° E 201.15'
Dept. of Interior Brass Plate in W hdwl. of E-W culvt. S 07° W 21.65'
Nail & Ottawa Co. Remon. Tag in W side PP S 10° E 198.46'
Nail & Ottawa Co. Remon. Tag in top guard post N 55° W 19.58'
C/L gravel road South, East 3', C/L gravel road E-W, North 5'
C/L gravel road North, East 50'

\$ 11.00 CORNER
\$ 1.00 PHOTO
\$ 1.00 PHOTO

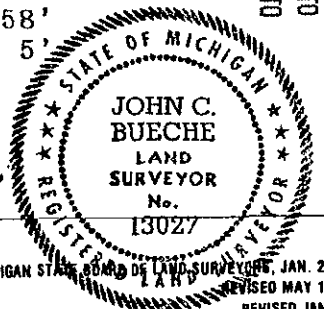

Signed by John C. Bueche
John C. Bueche, P.S.
Surveyor's Michigan License No. 13027

Date 11-7-96

Blendon Twp

M 5654.46'

A-13

M 3009.39'

GLO 45.75 (3019.80)

B-13

M 2645.07'

GLO 40.0

C-13

0.47'

GLO 71 (46.86')

A-1


GLO Pro 2970.05'
M 2962.39'

B-1

GLO 47.00
GLO 40.0
GLO Pro 2637.70'
M 2645.37'

C-1

M 46.70'
set mon

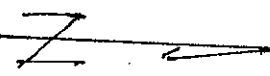

Zeeland Twp