

**Ottawa County Remonumentation  
LAND CORNER RECORDATION CERTIFICATE  
Filing Requirement of Act 74, Mich. P.A. 1970**

For corners in

Ottawa

(County)

Located In:

Corner Code ##

1. Public Land Survey	T <u>5N</u> R <u>14W</u>	<u>C-2 (W 4, 5)</u>
	T _____ R _____	<u>Zeeland Twp.</u>
	T _____ R _____	_____
	T _____ R _____	_____
2. Property Controlling in Section	S _____ T _____ R _____	_____
	S _____ T _____ R _____	_____
3. Miscellaneous Property in Sec.	S _____ T _____ R _____	_____
	S _____ T _____ R _____	_____

RECORDED

96 DEC 17 AM 10:43

*Phyllis Robinson*  
REGISTER OF DEEDS  
OTTAWA COUNTY, MI

Register of Deeds Stamp & File Number

4. Lot No. \_\_\_\_\_, Recorded Plat \_\_\_\_\_  
5. Private Claims \_\_\_\_\_

I, John C. Bueche, in a field survey on October 17, 19 96, do hereby certify that under requirements of P.A. 74, Michigan P.A. of 1970, the corner points mentioned in lines 1 and 2 above were in conformance with regulations and rules therefore as required in the current manual of survey instructions of the United States Department of the Interior, Bureau of Land Management or by a decree of a Court of Law and/or that the corner points mentioned in lines 3, 4 and 5 above were in conformance with the rules of the Michigan Board of Land Surveyors or by a Decree of a Court of Law; established, re-established, monumented, re-monumented, recovered, found as expressed below:

A	B	C	D	E	F	G	H	I	J	K	L	M
2	6	▲	5	4	3	2	1					
3												
4	7	8	9	10	11	12						
5												
6	18	17	16	15	14	13						
7												
8	19	20	21	22	23	24						
9												
10	30	29	28	27	26	25						
11												
12	31	32	33	34	35	36						
13												

**NOTE: Not more than 4 corners, all in the same town and range, may be recorded on this certificate.**

A. Description of original monument and accessories and/or subsequent restoration:

C-2 GLO	LCRC L1, P363	LCRC L3, P83
Set 1/2 mile post	May 4, 1972, fnd. stone	April 9, 1976 1 1/2" iron
Beech 20 S 70 E 6	Set iron pipe	NE cor. hse. #4395 S 45° W 98.43'
Beech 18 S 85 W 10	NE cor. att. gar. SW	PK in NW side PP N 50° E 43.69'
Calvin Britain	98.22'	PK in N side UP S 75° W 144.31'
April, 1832	NW cor. att. gar. SW	1/2" prop. iron N 45° W 46.39'
	116.85'	
	Nail in face PP NE	OVER
	43.18'	
	St. sign SE 40.60'	

B. Description of corner evidence found and/or method applied in restoring or reestablishing corner:

C-2 Found broken Ottawa Co. Mon. (Harrison 4" dia. down 0.8') in bit. road  
As per wit. in L1, P363; L3, P83; L4, P114


And is accepted as a careful and faithful perpetuation of the position of the original corner.

PEER APPROVED 11-11-96  
*M.D.T.*

C. Description of monument for corner and accessories established to perpetuate locating the position of the corner:

C-2 Ottawa Co. Mon. (Harrison 4" dia.) Set PK's 2.00' N & 2.00' W  
SE cor. of brick to hse. N 42° W 174.54'  
NE cor. of brick to gar. S 45° W 97.94'  
Top C/L hydt. S 43° E 46.33'  
Nail & Ottawa Co. Remon. Tag in S side PP N 56° E 43.83'  
Nail & Ottawa Co. Remon. Tag in S side PP S 60° W 143.50'  
On C/L gravel roads N, E, W, on C/L bit. South

\$ 11.00 CORNER  
\$ 1.00 PHOTO  
\$ 1.00 PHOTO

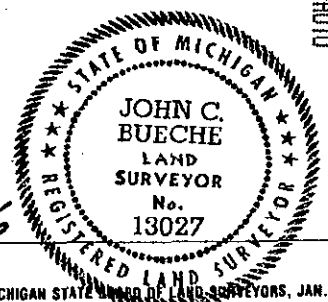

Signed by John C. Bueche  
John C. Bueche, P.S.  
Surveyor's Michigan License No. 13027

Date 11-7-96