

**Ottawa County Remonumentation
LAND CORNER RECORDATION CERTIFICATE
Filing Requirement of Act 74, Mich. P.A. 1970**

RECORDED

97 JUL 24 PM 2:25

Philip H. Robinson
REGISTER OF DEEDS
OTTAWA COUNTY, MI

For corners in

Ottawa

(County)

Located In:

Corner Code #

1. Public Land Survey	T <u>5N</u> R <u>14W</u>	<u>C-3 (SW, 5)</u>
	T _____ R _____	<u>Zeeland Twp.</u>
	T _____ R _____	_____
	T _____ R _____	_____
2. Property Controlling in Section	S _____ T _____ R _____	_____
	S _____ T _____ R _____	_____
3. Miscellaneous Property in Sec.	S _____ T _____ R _____	_____
	S _____ T _____ R _____	_____

Register of Deeds Stamp & File Number

4. Lot No. _____, Recorded Plat _____
5. Private Claims _____

I, John C. Bueche, in a field survey on April 1, 19 97, do hereby certify that under requirements of P.A. 74, Michigan P.A. of 1970, the corner points mentioned in lines 1 and 2 above were in conformance with regulations and rules therefore as required in the current manual of survey instructions of the United States Department of the Interior, Bureau of Land Management or by a decree of a Court of Law and/or that the corner points mentioned in lines 3, 4 and 5 above were in conformance with the rules of the Michigan Board of Land Surveyors or by a Decree of a Court of Law; established, re-established, monumented, re-monumented, recovered, found as expressed below:

NOTE: Not more than 4 corners, all in the same town and range, may be recorded on this certificate.

	A	B	C	D	E	F	G	H	I	J	K	L	M
2	8	5	4	3	2	1							
3													
4	7	8	9	10	11	12							
5													
6	18	17	16	15	14	13							
7													
8	19	20	21	22	23	24							
9													
10	30	29	28	27	26	25							
11													
12	31	32	33	34	35	36							
13													

A. Description of original monument and accessories and/or subsequent restoration:

C-3	LCRC L1, P721	LCRC L3, P109
GLO April, 1832	3/4" iron Nov., 1972	Iron pipe, Sept., 1976
Calvin Britain, DS	Nail in side PP NW 61.21'	PP SW 38.95'
Set cor. to	Nail in side PP NE 86.04'	PP NW 61.23'
sec. 5, 6, 7 & 8	C/L st. sign SE 35.55'	PP NE 86.10'
Maple 8 N 32 W 18		
Maple 12 S 44 E 14		OVER

B. Description of corner evidence found and/or method applied in restoring or reestablishing corner:

C-3 Fnd. cast iron mon. in Mon. Box (4" Harrison)
3/4" iron pipe, Oct., 1980
PP SW 39.06'
PP NW 61.17'
PP NE 86.10'
SW cor. garg. fnd. NE 161.10'

P.A. 345 OTTAWA COUNTY
PEER APPROVED 4/21/97

J.C.B.

And is accepted as a careful and faithful perpetuation of the position of the original corner.


C. Description of monument for corner and accessories established to perpetuate locating the position of the corner:

C-3 Cast iron mon. in Mon. Box (4" Harrison)
Nail & Ottawa Co. Remon. Tag in SW side PP N 35° W 61.33'
Nail & Ottawa Co. Remon. Tag in NW side PP N 24° E 86.27'
Nail & Ottawa Co. Remon. Tag in SE side 10" Oak S 42° W 98.76'
SW cor. brick to garg. N 42° E 160.94'
SE cor. brick to hse. N 60° E 214.31'
NW cor. brick to hse. S 45° E 151.85'
On C/L bit. E-W
C/L bit. N-S, E 1'±

\$ 11.00 CORNER

Signed by John C. Bueche
John C. Bueche, P.S.
Surveyor's Michigan License No. 13027

Date 4-16-97

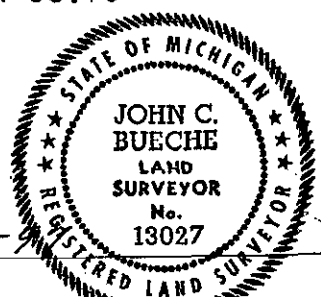

FORM APPROVED BY MICHIGAN STATE BOARD OF LAND SURVEYORS, JAN. 25, 1971
REVISED MAY 14, 1975
REVISED JAN., 1983

PART A - continued

LCRC L4, P114
3/4" iron pipe, Oct., 1980
PP SW 39.06'
PP NW 61.17'
PP NE 86.10'
SW cor. garg. fnd. NE 161.10'

LCRC L4, P173
Iron pipe, May, 1981
Same wit. as L4, P114