

SURVEY & REMONUMENTATION

APR 05 1996

COMMISSION

Ottawa County Remonumentation
LAND CORNER RECORDATION CERTIFICATE
Filing Requirement of Act 74, Mich. P.A. 1970

For corners in

Ottawa <small>(County)</small>	Located In:	Corner Code ##
1. Public Land Survey	T <u>5N</u> R <u>14W</u> T _____ R _____ T _____ R _____ T _____ R _____	C-5 (SE, 7) Zeeland Twp. _____ _____
2. Property Controlling in Section	S _____ T _____ R _____ S _____ T _____ R _____	_____ _____
3. Miscellaneous Property in Sec.	S _____ T _____ R _____ S _____ T _____ R _____	_____ _____

RECORDED

95 NOV 29 PM 1:41

Reginald Kullman
REGISTER OF DEEDS
OTTAWA COUNTY, MI

Register of Deeds Stamp & File Number

4. Lot No. _____, Recorded Plat _____
 5. Private Claims _____

I, John C. Bueche, in a field survey on November 10, 19 95, do hereby certify that under requirements of P.A. 74, Michigan P.A. of 1970, the corner points mentioned in lines 1 and 2 above were in conformance with regulations and rules therefore as required in the current manual of survey instructions of the United States Department of the Interior, Bureau of Land Management or by a decree of a Court of Law and/or that the corner points mentioned in lines 3, 4 and 5 above were in conformance with the rules of the Michigan Board of Land Surveyors or by a Decree of a Court of Law; established, re-established, monumented, re-monumented, recovered, found as expressed below:

	A	B	C	D	E	F	G	H	I	J	K	L	M
2	6	5	4	3	2	1							
3													
4	7	8	9	10	11	12							
5													
6	18	17	16	15	14	13							
7													
8	19	20	21	22	23	24							
9													
10	30	29	28	27	26	25							
11													
12	31	32	33	34	35	36							
13													

NOTE: Not more than 4 corners, all in the same town and range, may be recorded on this certificate.

A. Description of original monument and accessories and/or subsequent restoration:

C-5 GLO Calvin Britain, D.S. April 1, 1832 Set cor. 7, 8, 17 & 18 W. Ash 30 N 20 E 9 Beech 4 S 20 W 6	LCRC L2-P81, 1973 Found crossing spk. of 3/4" pipe Set cast iron mon. PP NNE 100.59' PP NNW 94.20' PP SSW 163.00'	LCRC L5-P294, 1988 Cast iron mon. PP NNE 100.73' PP NNW 94.31' Street sign SE 39.13' 12" Cherry ESE 159.37'
---	---	--

B. Description of corner evidence found and/or method applied in restoring or reestablishing corner:

C-5 Found iron in Mon. Box
 PP NNE 100.73'
 PP SSW 163.00'

And is accepted as a careful and faithful perpetuation of the position of the original corner.


P.A. 345 OTTAWA COUNTY

PEER APPROVED 11/20/95

Reginald Kullman

C. Description of monument for corner and accessories established to perpetuate locating the position of the corner:

C-5 Replaced Rerod with 3/4" x 24" Pin with Ottawa Co. Cap in Mon. Box
 Nail & Ottawa Co. Remon. Tag in NW side PP N 35 E 100.60'
 Nail & Ottawa Co. Remon. Tag in NE side PP N 40 W 46.44'
 Nail & Ottawa Co. Remon. Tag in SW side PP S 50 W 59.99'
 Nail & Ottawa Co. Remon. Tag in NE side PP S 30 E 51.64'
 C/L bit. N-S is 1.5'± West
 On C/L bit. E-W

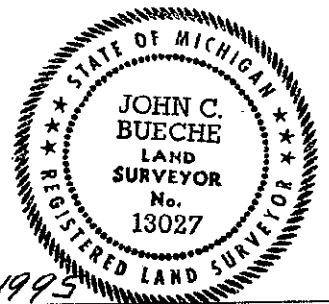

Signed by John C. Bueche
 John C. Bueche, P.S.
 Surveyor's Michigan License No. 13027

Date Nov. 16, 1995