

SURVEY & REMONUMENTATION

APR 24 1995

COMMISSION

Ottawa County Remonumentation
LAND CORNER RECORDATION CERTIFICATE
Filing Requirement of Act 74, Mich. P.A. 1970

RECORDED

94 DEC 15 AM 11:48

Dorothy A. Williams
REGISTER OF DEEDS
OTTAWA COUNTY, MI

For corners in
Ottawa
(County)

Located In: Corner Code #

1. Public Land Survey	T <u>5N</u> R <u>14W</u>	<u>C-10 (E$\frac{1}{2}$, 30)</u>
	T _____ R _____	<u>Zeeland Twp.</u>
	T _____ R _____	_____
	T _____ R _____	_____
2. Property Controlling in Section	S _____ T _____ R _____	_____
	S _____ T _____ R _____	_____
3. Miscellaneous Property in Sec.	S _____ T _____ R _____	_____
	S _____ T _____ R _____	_____

Register of Deeds Stamp & File Number

4. Lot No. _____, Recorded Plat _____
5. Private Claims _____

	A	B	C	D	E	F	G	H	I	J	K	L	M
2	6	5	4	3	2	1							
3													
4	7	8	9	10	11	12							
5													
6	18	17	16	15	14	13							
7													
8	19	20	21	22	23	24							
9													
10	30	29	28	27	26	25							
11													
12	31	32	33	34	35	36							
13													

I, John C. Bueche, in a field survey on December 5, 19 94, do hereby certify that under requirements of P.A. 74, Michigan P.A. of 1970, the corner points mentioned in lines 1 and 2 above were in conformance with regulations and rules therefore as required in the current manual of survey instructions of the United States Department of the Interior, Bureau of Land Management or by a decree of a Court of Law and/or that the corner points mentioned in lines 3, 4 and 5 above were in conformance with the rules of the Michigan Board of Land Surveyors or by a Decree of a Court of Law; established, re-established, monumented, re-monumented, recovered, found as expressed below:

NOTE: Not more than 4 corners, all in the same town and range, may be recorded on this certificate.

A. Description of original monument and accessories and/or subsequent restoration:
 C-10 GLO March, LCRC L3-P256 Iron Sept., 1978
 1832 Iron Feb., 1978 Cor. fe. post W 29.51'
 Calvin Britain, PP N 89 E 23.92' 18" Ash NW 75.70'
 D.S. 3" Elm S 43 W 40.51' PP E 23.45'
 Set post Fence post N 90 W 29.56' On C/L rd., on fe. lines E-W
 Hemlock 10 4" Ash clump N 49 W 41.62'
 S 14 W 17
 Beech 10
 N 47 E 28


B. Description of corner evidence found and/or method applied in restoring or reestablishing corner:
 C-10 Found 1/2" iron in Mon. Box 0.08' S of NE inside edge of Mon. Box
 PP N 89 E 23.92' PP E 23.45'
 4" Ash clump N 49 W 41.62' On C/L rd., on fe. lines E-W

And is accepted as a careful and faithful perpetuation of the position of the original corner.

P.A. 345 OTTAWA COUNTY
PEER APPROVED 12/12/94
Frederic P. [Signature]

C. Description of monument for corner and accessories established to perpetuate locating the position of the corner:
 C-10 Replaced 1/2" iron with Ottawa Co. Mon. (3/4" x 24" Pin with Alum. Cap) in Mon. Box that was moved
 Nail & Ottawa Co. Remon. Tag in S side PP E 23.77'
 Nail & Ottawa Co. Remon. Tag in SE side 24" Elm S 45 W 39.85'
 Nail & Ottawa Co. Remon. Tag in S side 8" Ash N 50 W 41.02'
 Nail & Ottawa Co. Remon. Tag in N side 8" Elm N 65 E 55.52'
 C/L bit. N-S, W 2'±
 On fence W, on field division E

Signed by John C. Bueche Date 12-12-94
Surveyor's Michigan License No. 13027

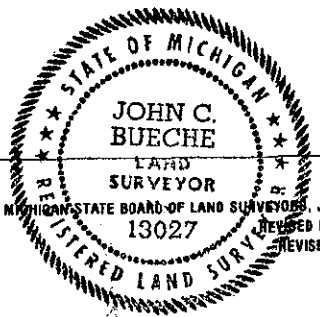

FORM APPROVED BY MICHIGAN STATE BOARD OF LAND SURVEYORS, JAN. 28, 1971
REVISED MAY 14, 1975
REVISED JAN., 1983