

RECORDED

97 JUL 26 PM 2:25

Ottawa County Remonumentation
LAND CORNER RECORDATION CERTIFICATE
Filing Requirement of Act 74, Mich. P.A. 1970

For corners in
Ottawa
(County)

Located In: Corner Code #

- 1. Public Land Survey T 5N R 14W C-12 (W $\frac{1}{2}$, 32)
T _____ R _____ Zeeland Twp.
T _____ R _____
T _____ R _____
- 2. Property Controlling S _____ T _____ R _____
in Section S _____ T _____ R _____
- 3. Miscellaneous S _____ T _____ R _____
Property in Sec. S _____ T _____ R _____
- 4. Lot No. _____, Recorded Plat _____
- 5. Private Claims _____

John C. Bueche
REGISTER OF DEEDS
OTTAWA COUNTY, MI

Register of Deeds Stamp & File Number

I, John C. Bueche, in a field survey on April 1, 19 97, do hereby certify that under requirements of P.A. 74, Michigan P.A. of 1970, the corner points mentioned in lines 1 and 2 above were in conformance with regulations and rules therefore as required in the current manual of survey instructions of the United States Department of the Interior, Bureau of Land Management or by a decree of a Court of Law and/or that the corner points mentioned in lines 3, 4 and 5 above were in conformance with the rules of the Michigan Board of Land Surveyors or by a Decree of a Court of Law; established, re-established, monumented, re-monumented, recovered, found as expressed below:

	A	B	C	D	E	F	G	H	I	J	K	L	M
2	6	5	4	3	2	1							
3													
4	7	8	9	10	11	12							
5													
6	18	17	16	15	14	13							
7													
8	19	20	21	22	23	24							
9													
10	30	29	28	27	26	25							
11													
12	31	32	33	34	35	36							
13													

NOTE: Not more than 4 corners, all in the same town and range, may be recorded on this certificate.

A. Description of original monument and accessories and/or subsequent restoration:

C-12	LCRC L1, P159	LCRC L3, P105
GLO April, 1832	3/4" pipe on fence N-S	Iron pipe, Aug., 1976
Calvin Britain, DS	Nov., 1971	Same L1, P159
Set 1/2 mile post	Nail in face 12" W.	
Beech 10 S 40 E 22	Cherry S 23.42'	
Beech 10 N 69 W 30	Nail in face 18" Ash	OVER
	NE 4.57'	
	M.P. Co. pipeline marker	
	post W 6.3'	

PA. 845 OTTAWA COUNTY
PEER APPROVED 4/21/97

J.C.B.

B. Description of corner evidence found and/or method applied in restoring or reestablishing corner:

C-12 Found 3/4" iron pipe	3/4" pipe on N-S fence, Sept., 1993
Nail in face 12" W.	W 6.3' face M.P. Co. pipeline marker
Cherry S 23.42'	N 40° E 5.14' 8-D nail S side 20" Ash
Nail in face 18" Ash	South 23.95' 8-D nail W side 14" Cherry
NE 4.57'	S 20° W 15.60' NE cor. alum. cor.
M.P. Co. pipeline marker	
post W 6.3'	

And is accepted as a careful and faithful perpetuation of the position of the original corner.


C. Description of monument for corner and accessories established to perpetuate locating the position of the corner:

C-12 Replaced iron pipe with Ottawa Co. Mon. (3/4" x 24" pin with alum. cap)
 Nail & Ottawa Co. Remon. Tag in S side 20" Ash N 20° E 5.10'
 Nail & Ottawa Co. Remon. Tag in W side 14" W. Cherry South 23.90'
 Nail & Ottawa Co. Remon. Tag in N side 24" Oak East 44.60'
 Face M.P. Co. pipeline marker West 6.3'
 NE cor. alum. hse. trailer #298 Lizbeth Dr. (2' above ground) S 20° W 15.60'
 On fence N & S
 C/L bit. N-S, West 112'±

\$ 11.00 CORNER

Signed by John C. Bueche
John C. Bueche, P.S.
Surveyor's Michigan License No. 13027

Date 4-16-97

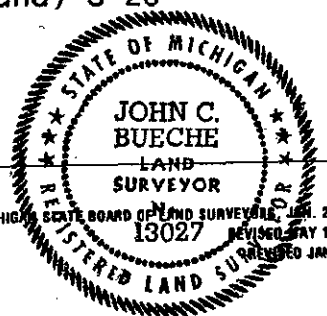

PART A - continued

LCRC L6, P268

3/4" pipe on N-S fence, Sept., 1993

W 6.3' face M.P. Co. pipeline marker

N 40° E 5.14' 8-D nail S side 20" Ash

South 23.95' 8-D nail W side 14" Cherry

S 20° W 15.60' NE cor. alum. cor.

Hse. trailer 2.0 A/G Hse. #298 Lizbeth Dr.