

RECORDED

Ottawa County Remonumentation
LAND CORNER RECORDATION CERTIFICATE
Filing Requirement of Act 74, Mich. P.A. 1970

97 JUL 24 PM 2:24

For corners in

Edythe R. Kesteven
REGISTER OF DEEDS
OTTAWA COUNTY, MI

Ottawa (County)	Located In:	Corner Code #
1. Public Land Survey	T <u>5N</u> R <u>14W</u>	<u>C-13 (SW, 32)</u> <u>Zeeland Twp.</u>
	T ___ R ___	_____
	T ___ R ___	_____
	T ___ R ___	_____
2. Property Controlling in Section	S ___ T ___ R ___	_____
	S ___ T ___ R ___	_____
3. Miscellaneous Property in Sec.	S ___ T ___ R ___	_____
	S ___ T ___ R ___	_____

Register of Deeds Stamp & File Number

4. Lot No. _____, Recorded Plat _____
5. Private Claims _____

	A	B	C	D	E	F	G	H	I	J	K	L	M
2	6	5	4	3	2	1							
3													
4	7	8	9	10	11	12							
5													
6	18	17	16	15	14	13							
7													
8	19	20	21	22	23	24							
9													
10	30	29	28	27	26	25							
11													
12	31	32	33	34	35	36							
13													

I, John C. Bueche, in a field survey on April 1, 19 97, do hereby certify that under requirements of P.A. 74, Michigan P.A. of 1970, the corner points mentioned in lines 1 and 2 above were in conformance with regulations and rules therefore as required in the current manual of survey instructions of the United States Department of the Interior, Bureau of Land Management or by a decree of a Court of Law and/or that the corner points mentioned in lines 3, 4 and 5 above were in conformance with the rules of the Michigan Board of Land Surveyors or by a Decree of a Court of Law; established, re-established, monumented, re-monumented, recovered, found as expressed below:

NOTE: Not more than 4 corners, all in the same town and range, may be recorded on this certificate.

A. Description of original monument and accessories and/or subsequent restoration:

C-13	LCRC L3, P105
GLO Nov., 1831	CIM, Aug., 1976
Lucius Lyon, DS	NE cor. metal sign post SW 71.55'
Set post corner	8" quadruple tree NW 32.62'
Secs. 31 & 32	Overisel Twp. cor. W 102.30'
Lynn 8 N 41 E 43	
Butternut 6 N 43 W 81	

B. Description of corner evidence found and/or method applied in restoring or reestablishing corner:

C-13 Found cast iron mon. in Mon. Box (4" Harrison)
Overisel cor. W 102.3'
NE cor. metal sign post SW 71.53'

And is accepted as a careful and faithful perpetuation of the position of the original corner.

P.A. 345 OTTAWA COUNTY
PEER APPROVED 4/21/97


J.C.B.

C. Description of monument for corner and accessories established to perpetuate locating the position of the corner:

C-13 Cast iron mon. in Mon. Box (4" Harrison)
Nail & Ottawa Co. Remon. Tag in W side 24" W. Cherry N 0° E 58.74'
Nail & Ottawa Co. Remon. Tag in E side PP S 20° W 148.24'
Nail & Ottawa Co. Remon. Tag in W side 20" Elm N 45° E 61.49'
Nail & Ottawa Co. Remon. Tag in top 8" x 8" wooden post on SW cor. bridge S 85° E 133.93'
SE cor. brick hse. #120 N 55° W 144.33'
Overisel cor. West 102.3'
C/L bit. E-W, North 1'±, C/L bit. North, West 60'±
C/L bit. South 46th Ave. West 102'±

\$ 9.00 CORNER

Signed by John C. Bueche, P.S. Date _____
Surveyor's Michigan License No. 13027

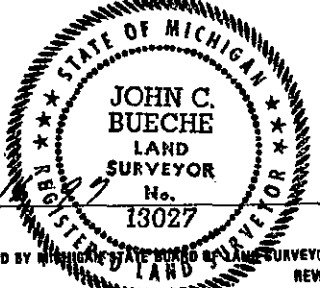

FORM APPROVED BY MICHIGAN STATE BOARD OF LAND SURVEYORS, JAN. 28, 1971
REVISED MAY 14, 1975
REVISED JAN., 1983