

1893

COMMISSION

Ottawa County Remonumentation
LAND CORNER RECORDATION CERTIFICATE
Filing Requirement of Act 74, Mich. P.A. 1970

RECORDED

93 DEC 15 AM 9:25

Deborah Williams
REGISTER OF DEEDS
OTTAWA COUNTY, MI

For corners in

Ottawa

(County)

Located In:

Corner Code #


1. Public Land Survey	T	5N	R	14W	D-3 (S $\frac{1}{2}$, 5)
	T		R		Zeeland Twp.
	T		R		
	T		R		
2. Property Controlling in Section	S		T	R	
	S		T	R	
3. Miscellaneous Property in Sec.	S		T	R	
	S		T	R	

Register of Deeds Stamp & File Number

4. Lot No. _____, Recorded Plat _____
5. Private Claims _____

I, John C. Bueche, in a field survey on November, 19 93, do hereby certify that under requirements of P.A. 74, Michigan P.A. of 1970, the corner points mentioned in lines 1 and 2 above were in conformance with regulations and rules therefore as required in the current manual of survey instructions of the United States Department of the Interior, Bureau of Land Management or by a decree of a Court of Law and/or that the corner points mentioned in lines 3, 4 and 5 above were in conformance with the rules of the Michigan Board of Land Surveyors or by a Decree of a Court of Law; established, re-established, monumented, re-monumented, recovered, found as expressed below:

NOTE: Not more than 4 corners, all in the same town and range, may be recorded on this certificate.

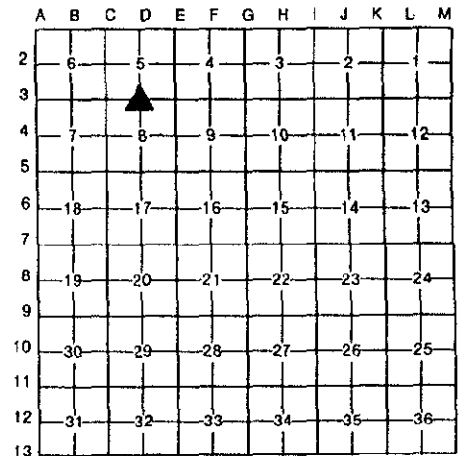

A. Description of original monument and accessories and/or subsequent restoration:

D-3 LCRC (L6, P52), Oct. 12, 1990 C.I.M. PP NE 126.75' 10" Tw. Elm SW 93.85' Top SE cor. 4' x 1.5' transformer Case NW 50.83'	D-3 LCRC (L3, P398), Nov. 1, 1979 C.I.M. C/L N end conc. culvt. NE 31.03' C/L S end conc. culvt. SE 31.83' C/L st. sign SE 40.80' C/L Tel. Box SW 167.36'	D-3 LCRC (L1, P721), Nov. 1, 1972 1/2" iron Nail in side PP E 53.08 Nail in side 30" Cherry NW 69.05 Nail in side 24" Maple SW 39.25 SW cor. hse. fnd. NE 85.40
--	---	---

B. Description of corner evidence found and/or method applied in restoring or reestablishing corner:

D-3 Found O.C. Mon. (4" Harrison) in Mon. Box PP NE 126.75' 10" Tw. Elm SW 93.85' Top SE cor. 4' x 1.5' transformer Case NW 50.83'	C/L Tel. Box SW 167.36'
---	-------------------------

And is accepted as a careful and faithful perpetuation of the position of the original corner.

C. Description of monument for corner and accessories established to perpetuate locating the position of the corner:

D-3 O.C. Mon. (4" Harrison) in Mon. Box Top SE cor. 1.5' x 4' transformer case "X" cut in top CMP culvt. "X" cut in top CMP culvt. Conc. Nail & O.C. Remon. Tag in W side 10" Tw. Elm Conc. Nail & O.C. Remon. Tag in W side PP On C/L "X" E & W, bit. road N & S gravel road	N 50° W 50.80' N 65° E 45.05' S 55° E 44.83' S 45° W 93.55' N 33° E 126.55'
---	---

Signed by John C. Bueche
Surveyor's Michigan License No. 13027

Date Nov. 29, 1993

FORM APPROVED BY MICHIGAN STATE BOARD OF LAND SURVEYORS, JAN. 28, 1971
REVISED MAY 14, 1975
REVISED JAN., 1983

