

RECORDED

Ottawa County Remonumentation
LAND CORNER RECORDATION CERTIFICATE 93 DEC 15 AM 9:25
 Filing Requirement of Act 74, Mich. P.A. 1970

Richard Callman
 REGISTER OF DEEDS
 OTTAWA COUNTY, MI

For corners in


Ottawa (County)	Located In:	Corner Code #
1. Public Land Survey	T <u>5N</u> R <u>14W</u>	<u>D-5 (S$\frac{1}{2}$, 8)</u> <u>Zeeland Twp.</u>
	T _____ R _____	_____
	T _____ R _____	_____
	T _____ R _____	_____
2. Property Controlling in Section	S _____ T _____ R _____	_____
	S _____ T _____ R _____	_____
3. Miscellaneous Property in Sec.	S _____ T _____ R _____	_____
	S _____ T _____ R _____	_____

Register of Deeds Stamp & File Number

4. Lot No. _____, Recorded Plat _____
 5. Private Claims _____

I, John C. Bueche, in a field survey on November, 19 93, do hereby certify that under requirements of P.A. 74, Michigan P.A. of 1970, the corner points mentioned in lines 1 and 2 above were in conformance with regulations and rules therefore as required in the current manual of survey instructions of the United States Department of the Interior, Bureau of Land Management or by a decree of a Court of Law and/or that the corner points mentioned in lines 3, 4 and 5 above were in conformance with the rules of the Michigan Board of Land Surveyors or by a Decree of a Court of Law; established, re-established, monumented, re-monumented, recovered, found as expressed below:

NOTE: Not more than 4 corners, all in the same town and range, may be recorded on this certificate.

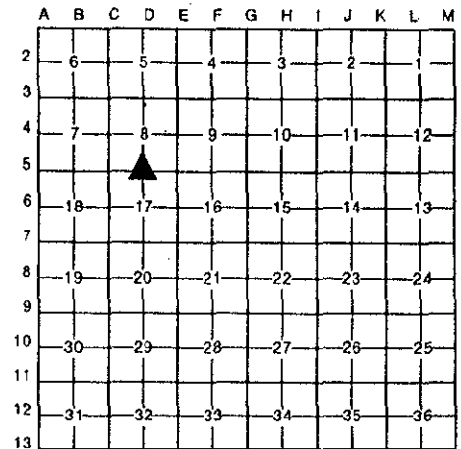

A. Description of original monument and accessories and/or subsequent restoration:

D-5 LCRC (L4, P54), May 15, 1980
 Set cast iron mon. inscribed
 "Section Corner"
 PP NW 43.86'
 TP NE 64.56'
 TP SE 46.43'
 P & T Pole SW 49.24'

D-5 LCRC (L2, P673), Oct. 22, 1974
 Found 1" iron pipe
 PP SW 48.55'
 PP NW 43.32'
 Support pole SE 45.86'

B. Description of corner evidence found and/or method applied in restoring or reestablishing corner:

D-5 Found O.C. Mon. (4" Harrison) 5" down in gravel road
 TP NE 64.56' PP SW 48.55'
 P & T Pole SW 49.24'

And is accepted as a careful and faithful perpetuation of the position of the original corner.

C. Description of monument for corner and accessories established to perpetuate locating the position of the corner:

D-5 O.C. Mon. (4" Harrison)
 Conc. Nail & O.C. Remon. Tag in SW side PP N 55° W 48.11'
 Conc. Nail & O.C. Remon. Tag in SW side PP S 55° W 49.24'
 "X" cut on S end CMP S 55° E 29.12'
 "X" cut on N end CMP N 60° E 30.81'
 On C/L gravel roads N-S, E-W



Signed by John C. Bueche
 Surveyor's Michigan License No. 13027

Date Nov. 29 1993