

SURVEY & REMONUMENTATION

APR 25 1995

COMMISSION

Ottawa County Remonumentation
LAND CORNER RECORDATION CERTIFICATE
 Filing Requirement of Act 74, Mich. P.A. 1970

RECORDED

94 DEC -8 PM 12:37

Phyllis Erdman
 REGISTER OF DEEDS
 OTTAWA COUNTY, MI

For corners in

Ottawa
 (County)

Located In:

Corner Code #

- | | | |
|------------------------------------|--------------------------|--|
| 1. Public Land Survey | T <u>5N</u> R <u>14W</u> | <u>D-9 (S$\frac{1}{2}$, 20)</u> |
| | T _____ R _____ | <u>Zeeland Twp.</u> |
| | T _____ R _____ | _____ |
| | T _____ R _____ | _____ |
| 2. Property Controlling in Section | S _____ T _____ R _____ | _____ |
| | S _____ T _____ R _____ | _____ |
| 3. Miscellaneous Property in Sec. | S _____ T _____ R _____ | _____ |
| | S _____ T _____ R _____ | _____ |

Register of Deeds Stamp & File Number

4. Lot No. _____, Recorded Plat _____
 5. Private Claims _____

	A	B	C	D	E	F	G	H	I	J	K	L	M
2	6	5	4	3	2	1							
3													
4	7	8	9	10	11	12							
5													
6	18	17	16	15	14	13							
7													
8	19	20	21	22	23	24							
9		▲											
10	30	29	28	27	26	25							
11													
12	31	32	33	34	35	36							
13													

John C. Bueche, in a field survey on October 14, 1994, hereby certify that under requirements of P.A. 74, Michigan P.A. of 1970, the corner points mentioned in lines 1 and 2 above were in conformance with regulations and rules therefore as required in the current manual of survey instructions of the United States Department of the Interior, Bureau of Land Management or by a decree of a Court of Law and/or that the corner points mentioned in lines 3, 4 and 5 above were in conformance with the rules of the Michigan Board of Land Surveyors or by a Decree of a Court of Law; established, re-established, monumented, re-monumented, recovered, found as expressed below:

NOTE: Not more than 4 corners, all in the same town and range, may be recorded on this certificate.

1. Description of original monument and accessories and/or subsequent restoration:

D-9 GLO March, 1832	LCRC L2-P353
Calvin Britain, D.S.	1/2" iron Oct., 1973
Set post	Nail in fe. post N 55 W 53.65'
Beech 10 N 1 E 18	Nail in PP N 15 W 108.13'
Beech 7 S 34 W 13	Nail in N 9 Tree Box Elder
	Tri. cluster N 88 E 64.87'

2. Description of corner evidence found and/or method applied in restoring or reestablishing corner:

D-9 Found 1/2" x 24" iron
 As per above wit.


And is accepted as a careful and faithful perpetuation of the position of the original corner.

P.A. 345 OTTAWA COUNTY
 PEER APPROVED 11/21/94

Madison D. Newbold

3. Description of monument for corner and accessories established to perpetuate locating the position of the corner:

D-9 Replaced 1/2" iron with Ottawa Co. Mon. (3/4" x 24" Pin) with Cap	
SW cor. brick garage	S 55 E 202.01'
SW cor. on top of stone pillar	S 15 E 137.20'
Ottawa Co. Remon. Nail & Tag in N side 24" Box Elder	E 66.47'
Nail & RLS Tag #14091 in E side PP	N 10 W 108.43'
C/L gravel rd. N-S, E 6'±	
On tree line W, on fence E	
C/L dirt dr. W 12'±	

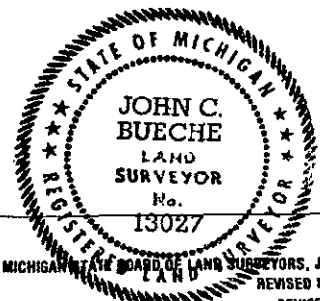

Signed by John C. Bueche
 John C. Bueche
 Surveyor's Michigan License No. 13027

Date 11-18-94