

**SURVEY & REMONUMENTATION**

APR 24 1995

**COMMISSION**

**Ottawa County Remonumentation LAND CORNER RECORDATION CERTIFICATE**

Filing Requirement of Act 74, Mich. P.A. 1970

RECORDED

94 DEC 15 AM 11:53

*Phyllis Kallman*  
REGISTER OF DEEDS  
OTTAWA COUNTY, MI

For corners in

Ottawa (County)	Located In:	Corner Code #
1. Public Land Survey	T <u>5N</u> R <u>14W</u>	<u>D-11 (S<math>\frac{1}{2}</math>, 29)</u> <u>Zeeland Twp.</u>
	T _____ R _____	_____
	T _____ R _____	_____
	T _____ R _____	_____
2. Property Controlling in Section	S _____ T _____ R _____	_____
	S _____ T _____ R _____	_____
3. Miscellaneous Property in Sec.	S _____ T _____ R _____	_____
	S _____ T _____ R _____	_____

Register of Deeds Stamp & File Number

4. Lot No. \_\_\_\_\_, Recorded Plat \_\_\_\_\_  
5. Private Claims \_\_\_\_\_

	A	B	C	D	E	F	G	H	I	J	K	L	M
2	6	5	4	3	2	1							
3													
4	7	8	9	10	11	12							
5													
6	18	17	16	15	14	13							
7													
8	19	20	21	22	23	24							
9													
10	30	29	28	27	26	25							
11													
12	31	32	33	34	35	36							
13													

I, John C. Bueche, in a field survey on December 6, 19 94, do hereby certify that under requirements of P.A. 74, Michigan P.A. of 1970, the corner points mentioned in lines 1 and 2 above were in conformance with regulations and rules therofore as required in the current manual of survey instructions of the United States Department of the Interior, Bureau of Land Management or by a decree of a Court of Law and/or that the corner points mentioned in lines 3, 4 and 5 above were in conformance with the rules of the Michigan Board of Land Surveyors or by a Decree of a Court of Law; established, re-established, monumented, re-monumented, recovered, found as expressed below:

**NOTE: Not more than 4 corners, all in the same town and range, may be recorded on this certificate.**

A. Description of original monument and accessories and/or subsequent restoration:

D-11 GLO March, 1832	LCRC L1-P133	LCRC L1-P157
Calvin Britain, D.S.	Iron pipe in Mon. Box Nov., 1971	3/4" iron in Mon. Box
Set post	C/L st. sign SE 38.65'	PP SE 38.72'
Ironwood	PP SE 38.60'	N end conc. culv. NE 47.52'
7 N 21 E 8		N end conc. culv. NW 42.02'
Beech		S end conc. culv. SW 40.22'
6 S 5 W 14		C/L pavt. N 1.5'
		OVER

B. Description of corner evidence found and/or method applied in restoring or reestablishing corner:

D-11 Found 1" pipe in Mon. Box 0.08' S of N inside edge  
C/L pavt. N 1.5'

And is accepted as a careful and faithful perpetuation of the position of the original corner.

PA. 345 OTTAWA COUNTY  
PEER APPROVED 12/12/94  
*Madison D. [Signature]*

C. Description of monument for corner and accessories established to perpetuate locating the position of the corner:


D-11 Replaced 1" pipe with Ottawa Co. Mon. (3/4" x 24" Pin & Alum. Cap) in Mon. Box which was moved

Top C/L hydt.	N 65 W	79.66'
Nail & Ottawa Co. Remon. Tag in E side PP	S 30 E	55.30'
Nail & Ottawa Co. Remon. Tag in S side PP	S 80 W	177.57'
NE cor. garage fnd.	S 45 W	144.47'
Nail & Ottawa Co. Remon. Tag in N side 22" Maple	S 70 E	128.88'

C/L bit. E-W, N 2'±  
On C/L bit. S, on C/L gravel N

Signed by John C. Bueche  
Surveyor's Michigan License No: 13027

Date 12-12-94

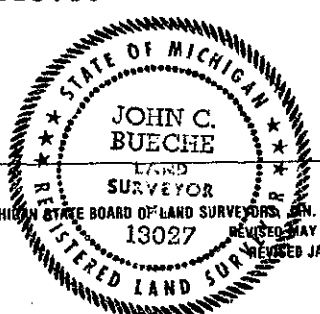

LCRC L2-P355

1 1/2" pipe in Mon. Box, Oct., 1973

C/L rd. 1.9'

S end 14 culv. S 45 W 40.1'

N end 14 culv. N 45 W 41.9'

Nail in PP S 50 E 38.65'

DATE # 3/20  
COST # 150  
# 200